


McPherson

Form 51-5M-11-31-Palace

Map No. **KANSAS** Sec. 14 Twp. 19 R. 2W

Well No. 2-13 Giffen Farm
Shell Pkt. Company

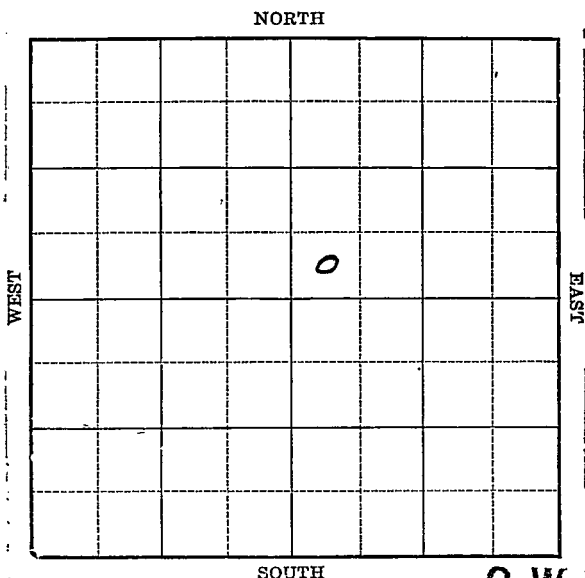

O. W. D. D

Location _____

Drilling Remarks _____

Rig Up _____

Drilling Remarks _____

RECORD

Cased _____ in. _____ ft.

Sand _____

Gas _____

Oil _____

Total Depth _____

PRODUCTION

1st 24 hrs. Nat. _____

1st 24 hrs. after shot _____

Gas _____ cu. ft. _____

Dry Hole _____

Abandoned _____

Mc Pherson

Map No. **KANSAS** Sec. 14 Twp 19 R. 2^W


Well No. 2-B Griffen Farm
Shell Pet. Company

 Ft. from N. Line

330 Ft. from S. Line

 Ft. from E. Line

330 Ft. from W. Line

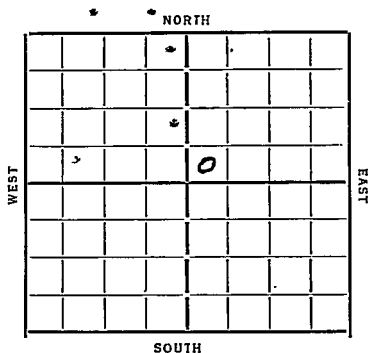

Date 1934

REPORT

O. W. D. D

5/16 Location

5/26 Bldg.

5/31 Bldg 136

6/7 " 2420

6/14 TC 2884 TD 3048 7 sq.

6/21 —

6/28 7" 3352 Rust

7/5 V 3355 Pay 3365-68

250' oil Tubing

7/11 Viola 3355 TD 3368

1000 acid 620 Bbls.

COMPLETED

OVER

1939

O. W. D. D

3/15

Old T. D. 3368'

P. B. to 2998'

Chat. 2884'

Perf. 100 shots 2940-62 $\frac{1}{2}$

1000 acid.

Pump 73 oil & 5 water in 8 hrs.

Potential 220 bbls.

FIRST REPORT

and

COMPLETED

KANSAS

Form 26-1M Dec. 2-20

Map No. 43 Sec. 14 Twp. 19 R. 2WWell No. 2B-RippenShell pet. Company

Contractor

SECTION PLAT

		0	

Ft. from N. Line

330 Ft. from S. Line

Ft. from E. Line

330 Ft. from W. Line

FIRST REPORTS

Location ✓

Rig up

Drilling and Remarks:

RECORD

Cased _____ in., _____ ft.

Sand _____

Gas _____

Oil _____

Total Depth _____

PRODUCTION

1st 24 hrs. Nat. _____

1st 24 hrs. after shot _____

Gas _____ Cu. Ft.

Dry Hole _____

Abandoned _____

Date

ORVAL MANNSCHRECK

5-16-34 19____ Scout

Returned _____

Cards *RPL*

Tracing *Mus*

France Map ☒

Scarborough Map *[Signature]*

Muddy Map ☒

Scarboro *[Signature]*

Map *[Signature]*

McPherson
Form 26—1M Bks.—2-29

Map No. 43 Sec. 14 Twp. 19 R. 2W

Well No. 2 - Giffen

Shell pit. Company _____

Contractor _____

COMPLETED

SECTION PLAT

		0	

_____ Ft. from N. Line

330 Ft. from S. Line

_____ Ft. from E. Line

330 Ft. from W. Line

Location _____

Rig up _____

Drilling and Remarks:;

1000 and

620 bbls

RECORD

Cased _____ in., _____ ft.

Sand Viola 3355

Gas _____

Oil _____

Total Depth 3368

PRODUCTION

1st 24 hrs. Nat. _____

1st 24 hrs. after shot _____

Gas _____ Cu. Ft.

Dry Hole _____

Abandoned _____

Date

7-11-34 19

ORVAL MANNSCHRECK
Scout


Map No. 43 Sec. 14 Twp. 19 R. 2WWell No. 2 Giffin "B"

Shell

Company

FIRST REPORT

Contractor

COMPLETED

SECTION PLAT

~~SW~~ SW NE990 Ft. from N. Line Ft. from S. Line Ft. from E. Line330 Ft. from W. Line

		0	

RITZ CANTON

Location

RECORD

Cased in., ft.Rig up Sand Drilling and Remarks: chat 2884Gas OTD-3368; P. B. 2998 Oil

Perf. 100 shots

Total Depth

2940-62½; 1000 Acid PRODUCTION

P/73 oil 5 water

1st 24 hrs. Nat.

in 8 Hrs.

1st 24 hrs. after shot

Poten. 220

Gas Cu. Ft.Dry Hole Abandoned

Date

H. D. Hatfield

MAR 15 1939

19

Scout

Misc. Small Maps
Cards
Tracing
France Map
Scarborough Map
Moody Map
Geological Dept.
Moody Flat Book