

Company

NORTH

WEST

FAST

SOUTH

O. W. D. D.

Location

Drilling Remarks

Rig Up

Drilling Remarks

RECORD

Cased _____ in. _____ ft.

Sand

Gas

Oil

Total Depth

PRODUCTION

1st 24 hrs. Nat.

1st 24 hrs. after shot

Gas.....cu. ft.

Dry Hole


Abandoned

Map No. KANSAS Sec. 14 Twp. 19 R. 2^w

Well No. 4-Meyers "13" Farm

M^cPherson & Shell Company

NORTH

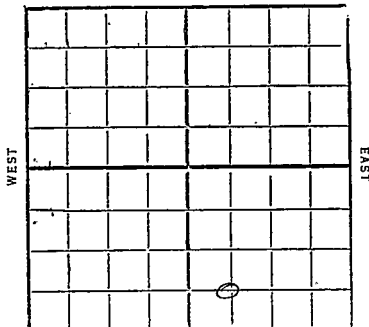

_____ Ft. from N. Line

660 Ft. from S. Line

_____ Ft. from E. Line

660 Ft. from W. Line

1931 **OWDD.**

SOUTH

Date

REPORT

7/22 Bldg rig (rotary)

7/29 10' S.P.

8/5 drlg 277'

8/12 " 2450

8/19 Top Chat 2882

8/19 Chat 2884-2928

8/19 rust

8/19 T.D. 2928

8/19 6 1/2 ft gas

8/19 Comp

1933 **OWDD**

11/28 Well Deepen

4/29 Ucla 3382-88

5" liner to 3382

Swab 24 bbls per hr 7 hrs

12/6 4 mil gas at 2928

12/13 2937 T.D. 5111 gas spraying for

12/20 J.D. 2937-444 bbls

COMPLETED

Map No. **KANSAS** Sec. **14** Twp. **19** R. **2**
 Well No. **43** **H** **Myers** **"B"**
McPherson & Shell Company
 Contractor

FIRST REPORTS

.....Ft. from N. Line
660 Ft. from S. Line
Ft. from E. Line
660 Ft. from W. Line

SECTION PLAT

Location.....

Rig up.....

Drilling and Remarks:

big Rotary Rig

RECORD

Cased.....in.,ft.

Sand.....

Gas.....

Oil.....

Total Depth.....

PRODUCTION

1st 24 hrs. Nat.....

1st 24 hrs. after shot.....

Gas.....Cu. Ft.

Dry Hole.....

Abandoned.....

Date

JUL 22 1931

192 **CHAS. L. SHERWOOD**
 Scout

McPherson

KANSAS
 Map No. _____ Sec. 14 Twp. 19 R. 2 ^W
43
 Well No. 4 Myers "B"

McPherson & Shels Company
 Contractor

COMPLETE

_____ Ft. from N. Line

660 Ft. from S. Line

_____ Ft. from E. Line

660 Ft. from W. Line

SECTION PLAT

Location _____

Rig up _____

Drilling and Remarks:

RECORD

Cased 1 in., _____ ft.
 Sand Chert 2884-2928
 Gas _____
 Oil _____
 Total Depth 2928

PRODUCTION

1st 24 hrs. Nat. _____
 1st 24 hrs. after shot _____
 Gas 6 1/2 11 Cu. F.
 Dry Hole _____
 Abandoned _____

Date

AUG 19 1931

CHAS. L. SHERWOOD

192

Sc

Map No. 43 Sec. 14 Twp. 19 R. 2WWell No. 4 - 'B' MeyersMeyerson & Shell Company

Contractor

FIRST REPORTS SECTION PLAT

Ft. from N. Line

660 Ft. from S. Line

Ft. from E. Line

660 Ft. from W. Line

Location

Rig up ☒

Drilling and Remarks:

O.T.D.
2928

RECORD

Cased _____ in., _____ ft.

Sand _____

Gas _____

Oil _____

Total Depth _____

PRODUCTION

1st 24 hrs. Nat. _____

1st 24 hrs. after shot _____

Gas _____ Cu. Ft.

Dry Hole _____

Abandoned _____

Date

11-28-33 O. Maunick Scout

Meyerson
 Map No. 43 Sec. 14 Twp. 19 R. 2W

Well No. H - Meyers B

Shell Ital Company

Contractor

SECTION PLAT

COMPLETED

Ft. from N. Line

660 Ft. from S. Line

Ft. from E. Line

660 Ft. from W. Line

		0	

Location

Rig up

Drilling and Remarks:

444 bbls

RECORD

Cased _____ in., _____ ft.

Sand _____

Gas _____

Oil _____

Total Depth 2937

PRODUCTION

1st 24 hrs. Nat. _____

1st 24 hrs. after shot _____

Gas _____ Cu. Ft.

Dry Hole _____

Abandoned _____

Date

12-27-33 192 O. Mammerschlag Scout