

McPherson

Map No. KANSAS Sec. 14 Twp. 19 R. 2 W


Well No. 9 B Meyers Farm
Shell Pet. Company

_____ Ft. from N. Line

330 Ft. from S. Line

1320 Ft. from E. Line

_____ Ft. from W. Line

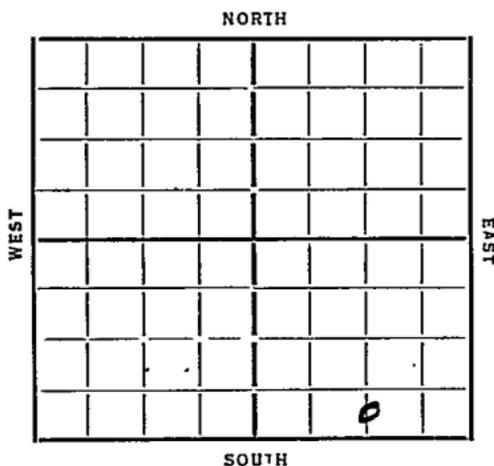

7/34 REPORT

9/19 Call
 9/27 —
 10/4 Dy 2280
 10/11 Chst 2895 B.L. 3114 7" 3360
 10/18 Dy 3363
 10/25 Viola 3363 TD 3374 1/2
80' oil 1000 acid
 11/1 Pump 61 Bbls 14 hrs.
 11/8 — 11/15 — 11/22 —
 11/27 Viola 3363 TD 3374 1/2
62 oil 4 water.

COMPLETED

KANSAS

Form 26 - 111 Bks. 2-29
Meperson

Map No. 43 Sec. 14 Twp. 19 R. 2W

Well No. 9B-Meyers

Shell pet Company

Contractor

SECTION PLAT

_____ Ft. from N. Line

330 Ft. from S. Line

1320 Ft. from E. Line

_____ Ft. from W. Line

FIRST REPORTS

RECORD

Location _____

Cased _____ in., _____ ft.

Rig up _____

Sand _____

Drilling and Remarks:

Gas _____

Oil _____

cead

Total Depth _____

PRODUCTION

1st 24 hrs. Nat. _____

1st 24 hrs. after shot _____

Gas _____ Cu. Ft.

Dry Hole _____

Abandoned _____

Date

9-19-34 19

ORVAI MANNING

Scout

Map No. 43 Sec. 14 Twp. 19 R. 2W


Well No. 9B-meyus

Shell petroleum Company

Contractor

COMPLETED

SECTION PLAT

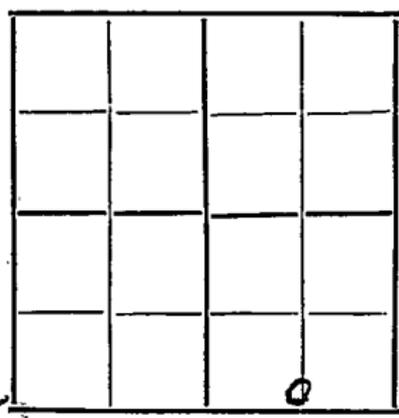

.....Ft. from N. Line

330 Ft. from S. Line

1320 Ft. from E. Line

.....Ft. from W. Line

RECORD

Location.....

Cased.....in.,ft.

Rig up.....

Sand Viola 3363

Drilling and Remarks:

Gas.....

Oil.....

Total Depth 3374 1/2

PRODUCTION

1st 24 hrs. Nat.....

1st 24 hrs. after shot.....

Gas.....Cu. Ft.

Dry Hole.....

Abandoned.....

*62 oil
4 water*

Date

11-27-37 192

ORVAL MANNSCHRECK
Scout