


Mc Pherson

Form 51-5M-11-31-Palace

Map No. **KANSAS** Sec. *14* Twp. *19* R. *2W*

Well No. *7 Meyers "B"* Farm

Shell Pet Company

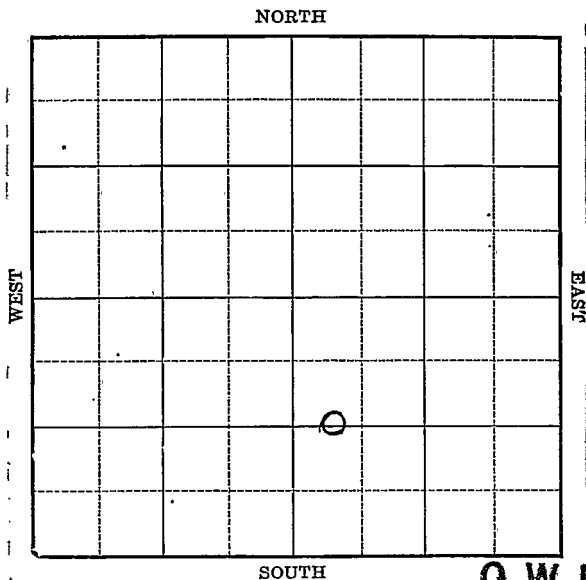

O. W. P. B.

Location_____

Drilling Remarks

Rig Up_____

Drilling Remarks

RECORD

Cased_____in._____ft.

Sand_____

Gas_____

Oil_____

Total Depth_____

PRODUCTION

1st 24 hrs. Nat._____

1st 24 hrs. after shot_____

Gas_____cu. ft.

Dry Hole_____

Abandoned_____

Mc Pherson


Map No. KANSAS Sec. 14 Twp 19 R. 2 W
Well No. 7 Meyers "B" Farm
Shell Pet Company

 Ft. from N. Line

1330 Ft. from S. Line

 Ft. from E. Line

330 Ft. from W. Line

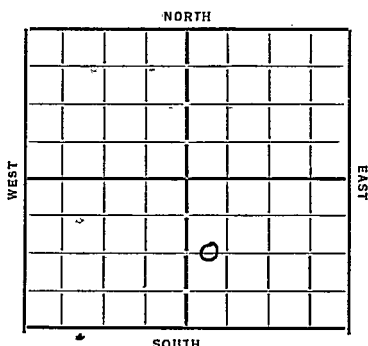

Date 1934

REPORT

O.W.P.B.

2/28 Location
3/8 Rigging Up.
3/15 Dlg 553 12" at 123
3/22 " 2276
3/29 Chat 2880 Dlg 2944
4/5 Viola 3357 7" 3359
7" 3357 Rust
4/14 Dlg Plug
4/19 TD 3400 swab 3 BBLs per hr.
4/26 1000 Hal acid Swab 25
bbls per hr.
5/2 Viola 3357 TD 3400
1000 acid 375 Bbls.

COMPLETED

OVER

1939

O. W. P. B.

3/15

Old T. D. 3400'

P. B. to 2994'

Chat. 2880' -

Perf. 69 shots 2920-46;
2000 acid.

Pump 60 oil & 10 water.

Perf. 39 shots 2946-60
1000 acid.

Pump 38 oil & 20 water 8 hours.
Potential 114 bbls.

FIRST REPORT

and
COMPLETED

KANSAS

Map No. 43 Sec. 14 Twp. 19 R. 2WWell No. 7-Meyers 'B'Shell pit Company

Contractor

SECTION PLAT

Ft. from N. Line

1320 Ft. from S. Line

Ft. from E. Line

330 Ft. from W. Line

FIRST REPORTS

Location ✓

Rig up

Drilling and Remarks:

RECORD

Cased.....in.,ft.

Sand.....

Gas.....

Oil.....

Total Depth.....

PRODUCTION

1st 24 hrs. Nat.....

1st 24 hrs. after shot.....

Gas.....Cu. Ft.

Dry Hole.....

Abandoned.....

Date

2-28-34 192 O. Mannschuet Scout

Returned

Cards

Tracing

France Map

Scarborough Map

Moody Map

Scarborough Flat Book

Moody Flat Book

KANSAS

Map No. 43 Sec. 14 Twp. 19 R. 2WWell No. 7-Meyers '131Shell pit. Company _____

Contractor _____

COMPLETED

SECTION PLAT

		0	

_____ Ft. from N. Line

1320 Ft. from S. Line

_____ Ft. from E. Line

330 Ft. from W. Line

Location _____

Rig up _____

Drilling and Remarks:

1000 acid375
bls.

RECORD

Cased _____ in., _____ ft.

Sand Viola 3357

Gas _____

Oil _____

Total Depth 3400

PRODUCTION

1st 24 hrs. Nat. _____

1st 24 hrs. after shot _____

Gas _____ Cu. Ft.

Dry Hole _____

Abandoned _____

Date

5-2-34 19

ORVAL MANNSCHRECK

Scout

Handwritten signature

Returned	
Cards	<i>PPS</i>
Tracing	<i>over</i>
France Map	<i>X</i>
Scarborough Map	<i>X</i>
Moody Map	<i>X</i>
Scarborough Plat Book	
Moody Plat Book	

McPherson

KANSAS

Map No. 43 Sec. 14 Twp. 19 R. 2WWell No. 7 Meyer "B"

Shell

Company

FIRST REPORT

Contractor

COMPLETED


SECTION PLAT

C W L SE

Ft. from N. Line

1305 Ft. from S. Line

Ft. from E. Line

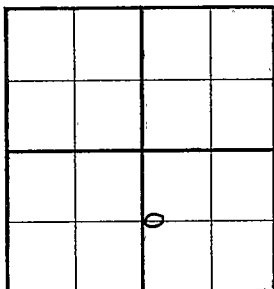330 Ft. from W. Line

RITZ CANTON POOL

Location

RECORD

Cased _____ in., _____ ft.

Rig up

Sand _____

Drilling and Remarks:

Gas _____

OTD-~~3375~~ ²⁴⁰⁰ ₂₈₈₀; PB 2994

Perf. 69 shots

Oil _____

Total Depth _____

2920-46; 2000 acid

PRODUCTION

P/60 oil, 10 water

1st 24 hrs. Nat. _____

Perf. 39 shots

1st 24 hrs. after shot _____

2946-60; 1000 acid

Gas _____ Cu. Ft.

P/38 oil, 20 water

Dry Hole _____

8 hours.

Abandoned _____

Poten. 114

Date

MAR 15 1939

19

H. D. Hatfield Scout

Misc. Small Maps

Cards

Tracing

France Map

Scarborough Map

Moody Map

Geological Dept.

Moody Plat Book