

McPherson


Form 51-5M-5-34-Palace

Map No. KANSAS Sec. 14 Twp. 19 R. 2W

Well No. 8-F Giffen Farm

Shell Mt. Company

NORTH

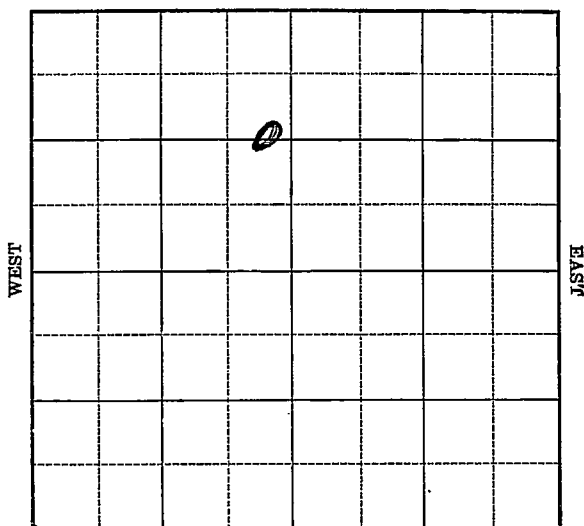

SOUTH

Location _____

Drilling Remarks _____

Rig Up _____

Drilling Remarks _____

RECORD

Cased _____ in. _____ ft.

Sand _____

Gas _____

Oil _____

Total Depth _____

PRODUCTION

1st 24 hrs. Nat. _____

1st 24 hrs. after shot _____

Gas _____ cu. ft.

Dry Hole _____

Abandoned _____


Map No. KANSAS Sec. 14 Twp. 19 R. 2W
Well No. 8-A Giffen Farm
Shell Pet. Company

Ft. from N. Line

Ft. from S. Line

Ft. from E. Line

Ft. from W. Line

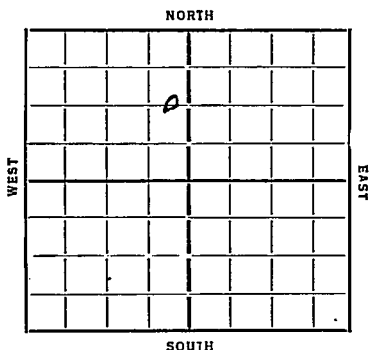

Date / /

REPORT

B. R.

Alg 627

4 2615

Chat 2890 Aly 3007

Blg 3014

3365 Csm 6" Rust

Viola 3365 T1) 3375

1000 acid pump 85 Bbls 8 hrs.

Viola 3365 TD 3375

1000 acid 301 oil

145 Water.

COMPLETED

KANSAS


Form 26-1M Hks. 2-25

Map No. 43 Sec. 14 Twp. 19 R. 24Well No. 8A - GiffenShell pet Company

Contractor

FIRST REPORTS

SECTION PLAT

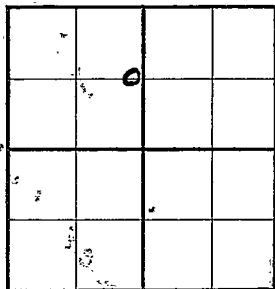

____ Ft. from N. Line

1314 Ft. from S. Line330 Ft. from E. Line

____ Ft. from W. Line

RECORD

Location _____

Rig up _____

Drilling and Remarks:

BK

Cased _____ in., _____ ft.

Sand _____

Gas _____

Oil _____

Total Depth _____

PRODUCTION

1st 24 hrs. Nat. _____

1st 24 hrs. after shot _____

Gas _____ Cu. Ft.

Dry Hole _____

Abandoned _____

Date

11-7-37

19

ORVAL MANNSCHRECK

Scout

Map No. 43 Sec. 14 Twp. 19 R. 2WWell No. 8A - GiffenShell Jet Company

Contractor

COMPLETED

SECTION PLAT

	0		

Ft. from N. Line

1314 Ft. from S. Line330 Ft. from E. Line

Ft. from W. Line

RECORD

Location

Cased _____ in., _____ ft.

Rig up

Sand Viola 3365

Drilling and Remarks:

Gas _____

Oil _____

Total Depth 3375

PRODUCTION

1st 24 hrs. Nat. _____

1st 24 hrs. after shot _____

Gas _____ Cu. Ft.

Dry Hole _____

Abandoned _____

Date

ORVAL MANNSCHRECK

1-2-35 192 _____ Scout301 oil
145 water