


Section 14 Township 19 Range 11-N

Well No. #2 Eberhart

Company Chalmette

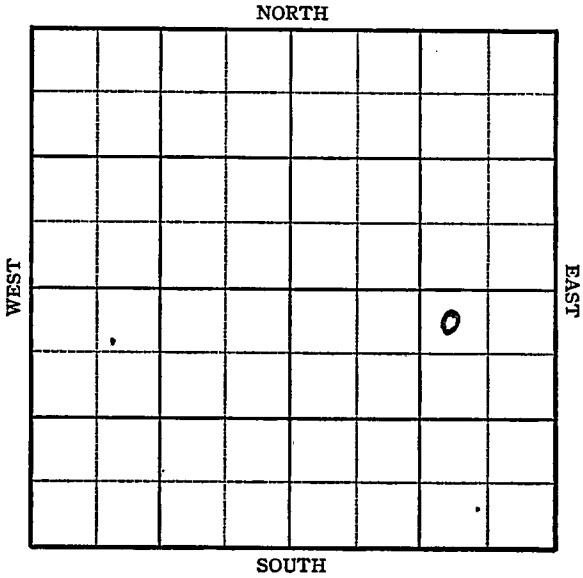

Sec. 14 Twp. 19 R. 11-W

Well No. #2 Eberhart Farm


Chalomette Company

330 Ft. from N. Line

_____ Ft. from S. Line

990 Ft. from E. Line

_____ Ft. from W. Line

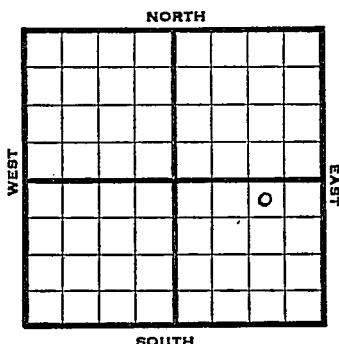

NW NE SE

1945 Elev. 1778' REPORT

12/12 Location

12/20 8" - 145' Drlg. 1107'

12/29 Drlg. 2797'

1946

1/10 Arb. 3330' T.D. 3345'

5" - 3332' SSO.

1/17 " " "

1/24 " " "

1/31 " " "

2/6 Arb. 3330

5" @ 3332

TD 3345'

Pump 86 Pot.

Grav. 41.0

COMPLETED

KANSAS Kansas Pool Name SilicaMap No. X-46 Sec. 14 Twp. 19 R. 11WWell No. 2 EberhartChalamette

Company

FIRST REPORT

Contractor

NW NE SE

SECTION PLAT

330 Ft. from N. Line

_____ Ft. from S. Line

990 Ft. from E. Line

_____ Ft. from W. Line

			o

Barton CountyLocation X

Rig up _____

Drilling and Remarks:

RECORD

Cased _____ in., _____ ft.

Sand _____

Gas _____

Oil _____

Total Depth _____

PRODUCTION

1st 24 hrs. Nat. _____

1st 24 hrs. after shot _____

Gas _____ Cu. Ft.

Dry Hole _____

Abandoned _____

Date

DEC 12 1945 19S. J. LEWIS

Scout

