


Section 14 Township 19 Range 14WWell No. #1 AlesCompany Ben Brock

NORTH

WEST

EAST

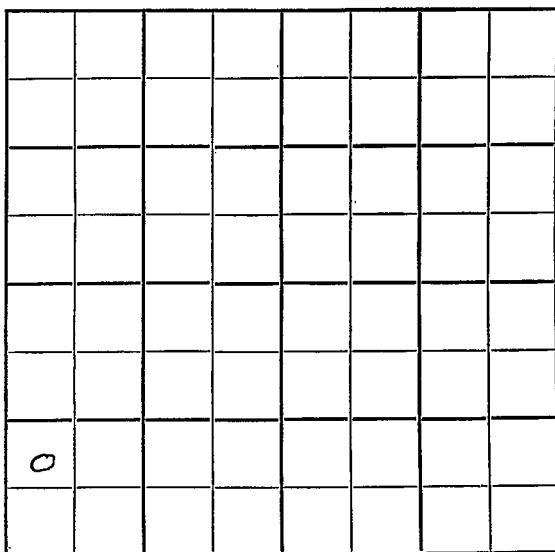

SOUTH

Sec. 14 Twp. 19 R. 1W

Well No. #1 Alefs Farm

Ben Brock Company

Wildcat Contractor

 Ft. from N. Line


990 Ft. from S. Line

 Ft. from E. Line

330 Ft. from W. Line

NW SW SW

Mag. \$2500 DHM

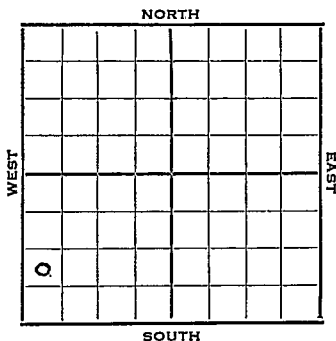

1952 Elev. 1877' REPORT

2/27 Spud 2-22-52
Anhy 814'
8" @ 830'
Drlg. 1960'

3/5 Heeb. 3107 Br Li 3196
Lans. 3208
DST 3212-33 3/4 hr 33' OCM
656# DST 3259-80 1 hr 120' SW
622#
DST 3284-3300 1 hr. 120' SW 1042#
DST 3325-38 1/2 hr. 210' O&GCM & 120'
oil
DST 3356-79 1/2 hr. 20' SOCM
Drlg. 3402'

3/11 Arb. 3474
DST 3474-79, 1/2 hr. 30' HOCM 240' oil
875# RTD 3479 5" @ 3475 DD 3482
S/ 38 BO 15 hrs. to A

3/19 POP

3/25 POP

4/1 POP

4/9 NR

4/23 "

4/30 "

OVER

1952

5/7

Ran Gamma-Ray PB to ?

12/3456-59 Attempted sq/ CO 3482'
Set retainer @ 3434' Sq open hole &
perfs. CO 3476' 24/3469-75 500 A
S/1½ BW plus 1/4 BOPH Sq off WO
orders.

5/14

CO 3480 23/3474-77 15/3477-79½
opn hole at 500A S/2 BO & 1/4
BWPH PB3390 36/3373-79 att 500 A
VSSO PB 3361 42/3334-41
ran tub Start to F 20 BO 20 mins
opn tubing

5/21

F 32 BO 24 hrs 12/64" ck.

5/28

NR

6/6

Spud 2-22-52

Oil Well TD 3482'

Anhy 814' 8" @ 30' Heeb. 3107

Br Li 3196 Lans. 3208

DST 3212-33 open 3/4 hr. rec. 33' ocm

DST 3259-80 open 1 hr. rec. 330' sw

DST 3284-3300 open 1 hr. rec. 120' sw

DST 3325-38 open ½ hr. rec. 210' O&GCM

120' oil DST 3356-79 open ½ hr. rec.

20' socm Arb. 3474 DST 347179 open

½ hr. rec. 30' hocm 240' oil TD 3479

5" @ 3475 DD 3482 S/ 38 bo 15 hr.

12/ 3456-59 CO to 3482 SP 3434

CO to 3476 24/ 3469-75 500 A

S/ 1½ bw ¼ boph CO to 3480

23/ 3474-77 15/ 3477-79 500 A


S/ 2 bw ¼ boph PB 3390 36/ 3373-79

500 A BSSO PB 3361 42/ 3334-41

SI overnite F/ 20 bo 20 min. F/ 32 bo

24 hr. Comp. 30 bopd


COMPLETED

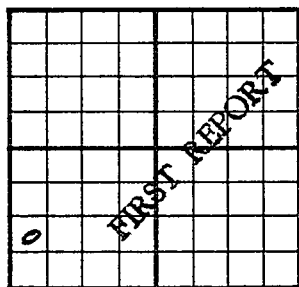County **Barton** State **Kansas**Sec. **14** (Blk. Twp.) **19** (Sur. Rge.) **14W** Map No.Operator **Ben Brock**Well No. **1** Farm **Alefs**Elev. Location **NW SW SW**990 Ft. From **S** Line **SW**330 Ft. From **W** Line Quarter1st. Report **FEB 27 1952**

Completion

Remarks **Mag. \$ 2500.--DHM**Spudding Date **2-22-52**Drlg. Data **Wildcat****Anhy 814 8" @ 830 Drlg. 1960****J. G. McGEHEE**

County Barton State Kansas
 Sec. 14 (Blk. 19 (Sur. 14W Map No.
 Operator Ben Brack
 Well No. 1 Farm Alefs
 Elev. 1877 Location NW SW SW

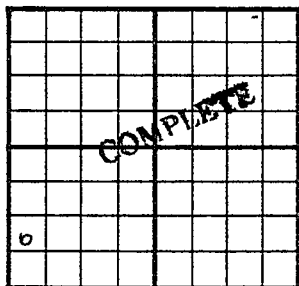

990 Ft. From S Line SW
330 Ft. From W Line Quarter
 1st. Report
 Completion JUN 4 1952
 Remarks Alefs Pool

Spudding Date 2-22-52

Drlg. Data Oil well TD 3482

Anhy 814 8" @ 830 Heeb. 3107

Br. lime 3196 Lans. 3208 DST 3212-33

open 3/4 hr. Rec. 33' ocm DST 3259-80

open 1 hr. Rec. 330' sw DST 3284-3300

open 1 hr. Rec. 120' sw DST 3325-38

open 1/2 hr. Rec. 210' o & gcm 120' oil

DST 3356-79 open 1/2 hr. Rec. 20' socm

Arb. 3474 DST 3471-79 open 1/2 hr.

Rec. 30' hocm 240' oil TD 3479

5" @ 3475 DD 3482 S/ 38 bp 15 hr.

12/ 3456-59 CO to 3482 SP 3434

CO to 3476 24/ 3469-75 500 A

S/ 1 1/2 bw 1/4 boph CO to 3480 23/ 3474-77

15/ 3477-79 500 A S/ 2 bw 1/4 boph

J. G. McGEHEE

Drig. Data

PB 3390 36/ 3373-79 500 A VSSO

PB 3361 42/ 3334-41 shut in overnite

F/ 20 bo 20 min. F/ 32 bo 24 hr.

Comp. 30 bo pd

NOV 9 1952

Scout Cards
Land Small Map
Land Wall Map
Tracings
France Map
Pierce Map
Misc.