


Section 14 Township 19 Range 14 W

Well No. # 1 A1efs

Company Carl Todd Drlg.

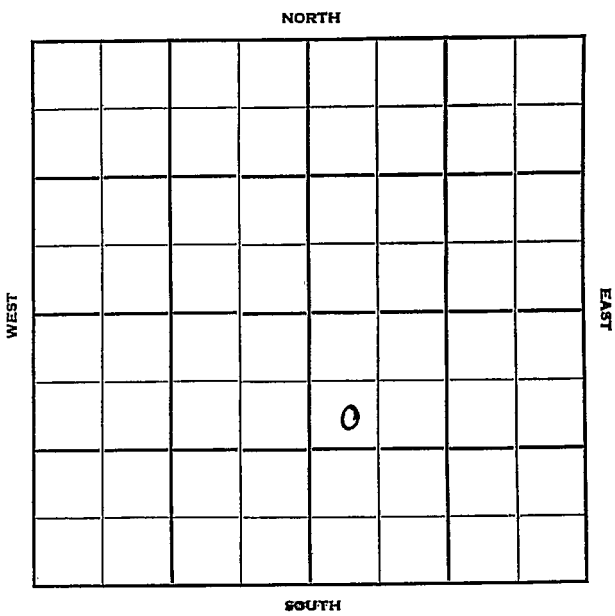


Sec. 14 Twp. 19 R. 14W

Well No. #1 Alefs Farm

Carl Todd Drlg. Company

Todd Drlg. - Contr. Contractor

990' Ft. from N. Line  
 \_\_\_\_\_ Ft. from S. Line  
 \_\_\_\_\_ Ft. from E. Line  
330' Ft. from W. Line

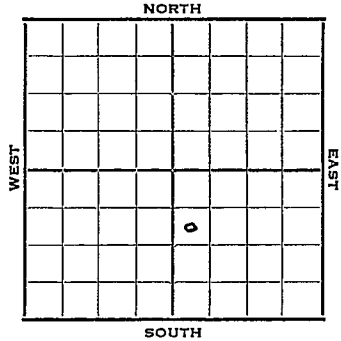

SW NW SE

1952

Elev. 1874' REPORT

3/19

Spud 3-16-52  
8" @ 820

WOC

3/25

Anhy 805' Heeb 3113' Br. Li 3205'  
 KC 3218'  
 DST 3211-41 1/2 hr, 500' gas, 150' O & GCM  
 50' SW, 800#-15"

Drlg 3394'

4/1

B KC 3396' Cong. 3443' Arb. 3477'  
 TD 3482' 5" @ 3479 DD to 3483' SSO  
 10/3479-83 500 A DD to 3494'

4/9

Spud 3-16-52  
 D & A TD 3496' 8" @ 820  
 Anhy 805' Heeb 3113' Br. li 3205'  
 KC 3218'  
 DST 3211-41 open 1/2 hr. rec 500' gas  
 150' O & GCM, 60' SW  
 B KC 3396' Cong. 3443' Arb. 3477'  
 TD 3482' 5" @ 3479 DD 3483'  
 10/3479-83 500 A DD 3494'  
 PB 3444' 12/3343-46 12/3347-50  
 500 A 24/3215-21 500 A 3 1/2 BFPH  
 TD 3496'  
 D & A

**ABANDONED**



