



Morgan & Flynn et al Company

Barton

NORTH

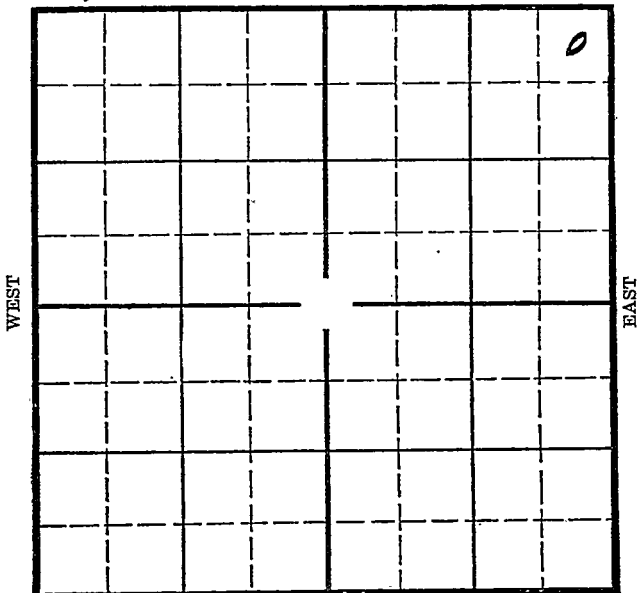

Location _____

Drilling Remarks _____

Rig Up _____

Drilling Remarks _____

RECORD

Cased _____ in. _____ ft.

Sand _____

Gas _____

Oil _____

Total Depth _____

PRODUCTION

1st 24 hrs. Nat. _____

1st 24 hrs. after shot _____

Gas _____ cu. ft. _____

Dry Hole _____

Abandoned _____



Map No. 82 Sec. 14 Twp. 19 R. 14W

Well No. 1 - Amerine

Morgan & Flinn Company

Contractor

NO REPORTS

SECTION PLAT

330 Ft. from N. Line

..... Ft. from S. Line

330 Ft. from E. Line

..... Ft. from W. Line

			0

Location.....

Rig up.....

Drilling and Remarks:

cellar

RECORD

Cased..... in., ft.

Sand.....

Gas.....

Oil.....

Total Depth.....

PRODUCTION

1st 24 hrs. Nat.....

1st 24 hrs. after shot.....

Gas..... Cu. Ft.

Dry Hole.....

Abandoned.....

Date

ORVAL MANSCHE

12-11-35 192.....

Scout

Map No. 82 Sec. 14 Twp. 19 R. 14W

Well No. 1-Amerine

Morgan & Flynn et al Company

Contractor

COMPLETED

330 Ft. from N. Line

..... Ft. from S. Line

330 Ft. from E. Line

..... Ft. from W. Line

SECTION PLAT

			0

Location.....

Rig up.....

Drilling and Remarks:

hfw

D + a,

RECORD

Cased..... in., ft.

Sand Sil 3550

Gas.....

Oil.....

Total Depth 3668

PRODUCTION

1st 24 hrs. Nat.....

1st 24 hrs. after shot.....

Gas..... Cu. Ft.

Dry Hole.....

Abandoned.....

Date

MAR 18 1936

ORVAL MANNSCHRECK

Scout