

Section 14 Township 19 Range 13WWell No. #1 DodgeCompany Crowe Drlg.

NORTH

			0				

WEST

EAST

SOUTH

Barton

Sec. 14 Twp. 19 R. 13W

Well No. #1 Dodge Farm

Crowe Drlg. Company

Contractor


330' Ft. from N. Line

 Ft. from S. Line

330' Ft. from E. Line

 Ft. from W. Line

NE NE NW

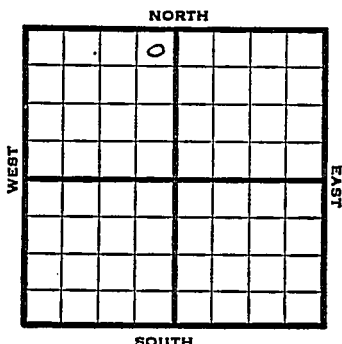

1951

Elev. 1912: REPORT

1/24

MIR

2/7

Spud 1-24-51

D&A TD 3530

8" @ 210' Anhy 775-95

Heeb. 3115' Br Lime 3216

KC 3233'

DST 3235-3305 opn $\frac{1}{2}$ hr

Rec. 1475' sw Cong. 3468'

Arb. 3493'

DST 3494-3503 opn 1 hr

Rec. 15' mud TD 3530

D&A

ABANDONED

County Barton State Kansas

Sec. 14 (Blk. Twp.) 19 (Sur. Rge.) 13W Map No.

Operator Crowe Drlg.

Well No. 1 Farm Dodge

Elev. Location NE NE NW

			0			

330 Ft. From N Line NE

330 Ft. From E Line Quarter

1st. Report JAN 24 1951

Completion

Remarks

Spudding Date

Drlg. Data

M I R

J. E. TYRA

County Barton State KansasSec. 14 (Blk.
Twp.) 19 (Sur.
Rge.) 13W Map No.Operator Crowe Drlg.Well No. 1 Farm DodgeElev. 1912 Location NE NE NW

330 Ft. From N Line NW330 Ft. From E Line Quarter

1st. Report

Completion FEB 7 1951

Remarks

Spudding Date 1-24-51Drlg. Data D & A TD 35308" @ 210 Anhy 775-95 Heeb. 3115Br. lime 3216 KC 3233 DST 3235-3305open $\frac{1}{2}$ hr. Rec. 1475' sw Cong. 3468Arb. 3493 DST 3494-3503 open 1 hr.Rec. 15' mud TD 3530D & A

J. E. TYRA