

Section 14 Township 19 Range 13WWell No. #1 MusserCompany Aledo & Murphin

NORTH

0							

SOUTH

WEST

EAST

Barton

KANSAS

Sec. 14 Twp. 19 R. 13W

Well No. #1 Musser ☒ Farm

Aledo & Murphin Company

Aledo & Murphin Contractor

Wildcat


 Ft. from N. Line

330 Ft. from S. Line

 Ft. from E. Line

330 Ft. from W. Line

SW SW SW

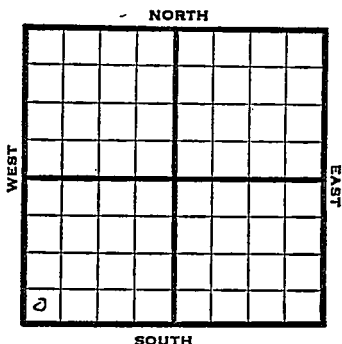

1951

Elev. 1843' REPORT

10/31 RUR

11/14

Spud 10-30-51

D & A TD 3473' 8" @ 430'

Top. 2832' Heeb 3066' Br. line 3168'


Lans. 3187' B KC 3399' Cong. 3421'

Arb. 3438-73' TD

D & A

ABANDONED

County Barton State Kansas
 Sec. 14 (Blk. Twp.) 19 (Sur. Rge.) 13W Map No. _____
 Operator Aledo & Murphin
 Well No. 1 Farm Musser
 Elev. _____ Location SW SW SW

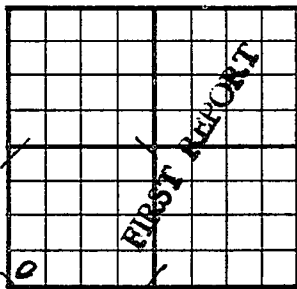

330 Ft. From S Line SW
330 Ft. From W Line Quarter

Ist. Report OCT 31 1951

Completion _____

Remarks _____

Aledo & Murphin - Contr.

Spudding Date _____

Drlg. Data Wildcat

RUR


J. E. TYRA

County Barton State Kansas
 Sec. 14 (Blk. 19 (Sur. 13W Map No. (Twp.) (Rge.)

Operator Aledo & Murfin

Well No. 1 Farm Musser

Elev. 1843 Location SW SW SW

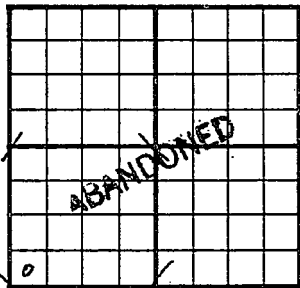

330 Ft. From S Line SW

330 Ft. From W Line Quarter

Ist. Report

Completion NOV 14 1951

Remarks Wildcat

Murfin - Contr.

Spudding Date 10-30-51

Drlg. Data D & A TD 3473

8" @ 430 Top. 2832 Heeb. 3066

Br. lime 3168 Lans. 3187 B KC 3399

Cong. 3421 Arb. 3438-73 TD

D & A

J. E. TYRA