

(WH8-DC31) ✓

Rush

KANSAS

SECTION 14 TOWNSHIP 19 S RANGE 18 W

WELL NO. # 1 Jecka

COMPANY Leben Drlg. Co.

NORTH

SE SE NE

WEST

EAST

							0

SOUTH

HOT FILE

Rush

KANSAS


SEC.	TWP.	R.
14	19 S	18 W

WELL NO. # 1 Jecka FARM

COMPANY Leben Drlg. Inc.

CONTRACTOR Co. tools
Wildcat

_____ FT. FROM N. LINE
 _____ FT. FROM S. LINE
 _____ FT. FROM E. LINE
 _____ FT. FROM W. LINE

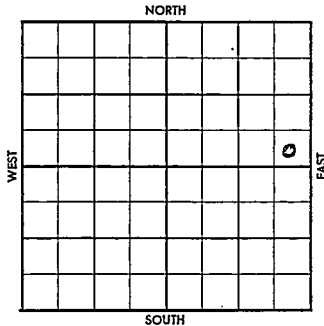

SE SE NE
 Phillips-Support
 SDX-DHC-\$3000.00 (S-28990)

1958	ELEVATION	REPORT	(WH8-DC31)
------	-----------	--------	------------

7/15 Arbuckle formation test appx 4000'
 To be commenced by August 25, 1958
 To be completed by Sept. 25, 1958
 (See DHC Agrt 7-15-58)

8/6 Location (FR Tkt)
 8/7 " (WH-Wkly Sct. Ltr)
 8-14 Drlg. 2325,
 Spud 8-8-58
 8/21 Drlg. 3880'
 Heeb 3489', Tor. 3508', Lans 3538'
 BKC 3822' (WH-Wkly Sct. Ltr)
 8/27 Spud 8-8-58
 Comp. 8-20-58
 TD 4022'. P & A (WH-Comp. Letter)

ABANDONED

~~Twp.~~ ~~Pool~~ X

WILDCAT

S-513-B

County Rush Elev. _____
 Sec. 14 Twp. 19 Rge. 18W
 Company Leben Drlg.
 Farm Name Jecka No. 1

TOPS	DEPTH	LOG	DATUM
Anh.			
Tp.			
H.			
Tr.			
Dg.			
B.L.			
L.			
K.C.			
B.K.C.			
Ce.			
C.			
M.			
M.			
K.			
Mz.			
Mq.			
V.			
S.			
S.			
A.			
R.			
Pf.			
G.			
T.D.			

Loc. in Sec. _____
SE SE NE
 Geol. _____
 Contr. _____
Co. Tools #2
 Pool _____
Wildcat

FIRST REPORT
 AUG 6 1959

Date Comm. _____ (SMC - Support.)
Location _____ (Phillips - Support)

AUG 17. 1959

Twp. Pool

Co. Facet

Country Rush Elev 21320F 21350F
 Sec. 14 Twp. 19 Rge. 18W
 Company Leben Drlg.
 Farm Name Jecka No. 1

TOPS	DEPTH	LOG	DATUM
Anh.			
Ip.			
H.	<u>3489</u>	<u>3486</u>	
Tr.	<u>3508</u>	<u>3507</u>	
Dg.			
B.L.			
L.	<u>3538</u>	<u>3537</u>	
K.C.			
B.K.C.	<u>3822</u>	<u>3814</u>	
Ce.			
C.			
M.			
M. <u>Aam</u>		<u>3821</u>	
K.			
M. <u>B.P. Cong</u>		<u>3878</u>	
Mq.			
V.			
S. <u>Cong Chest</u>		<u>3920</u>	
S.			
M. <u>3987</u>	<u>3986</u>		
R.			
Pf.			
G.			
T.D.	<u>4022</u>		

Loc. in Sec. SF SE NE
 Geol. (NH8-DC31)
 Contr. Co. Tools #2
 Pool Wildcat
ABANDONED
 AUG 27 '58

Date Comm. 8-8-58 (SMC - Support)
8-8-58 243/175 (Phillips - Support)

AUG 13 '58 ϕ 2325 AUG 20 '58 Tops.
 ~~ϕ 3758~~ ϕ 3880 AUG 21 '58 X TOP
no + sts 79' Low

log 4022
DoA

SEP 3 1958

5-26-57
M. M. C.

Co.
Lse.
No.
Sec.
T.
R.