

Ness


KANSAS

SECTION 14 TOWNSHIP 19 RANGE 26W

WELL NO. #1 Cline

COMPANY Bennett & Roberts

NORTH

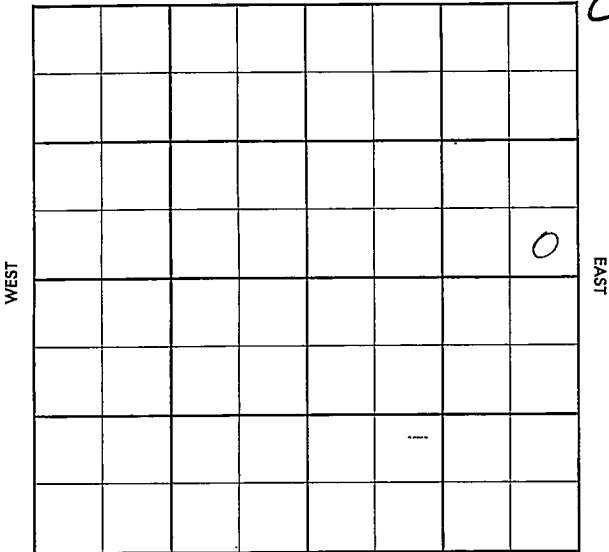

SOUTH

County Ness Elev. _____
 Sec. 14 Twp. 19 Rgs. 26W
 Company Bennett & Roberts
 Farm Name Gline No. 1

TOPS	DEPTH	LOG	DATUM
Anh.			
Tp.			
H.			
Tr.			
Dg.			
Bl.			
L.			
K.C.			
B.K.C.			
Ce.			
C.			
M.			
M.			
K.			
Mz.			
Mo.			
V.			
S.			
S.			
A.			
R.			
PE.			
G.			
TD.			

Loc. in Sec. SE SE NE

Geol. _____
 Contr. Co. tools

Pool Wildcat

FIRST REPORT	
	0
<u>1/2 Mile</u>	
MAY 9 '36	

Date Comm. 5-5-56
 drlg.

~~35~~

Co.
 Lse.
 No.
 Sec.
 T.
 R.

