


KANSAS Barton

Form 51-5M-11-38-Palace

Section 14 Township 19 Range 15-W

Well No. #1 Olga Kruckenberg

Company Amerada

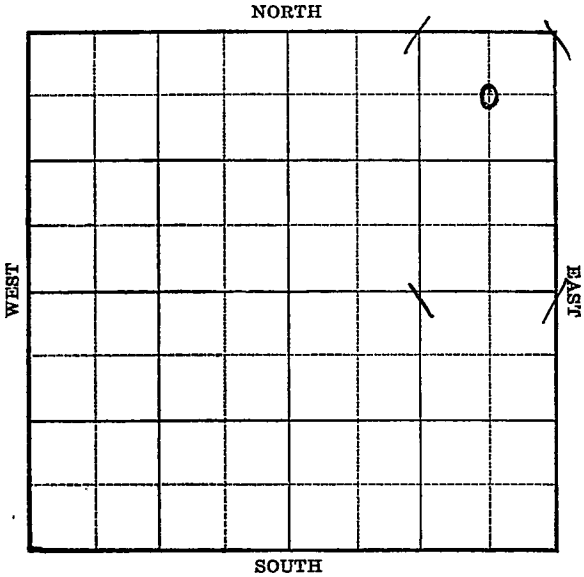

Sec. 14 Twp. 19 R. 15-W

Well No. #1 Olga Kruckenberg Farm
Amerada Company


660 Ft. from N. Line

_____ Ft. from S. Line

660 Ft. from E. Line

_____ Ft. from W. Line

Elev. 1950

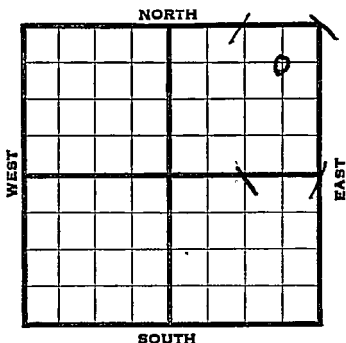

1938	REPORT
12/7	B.R.R.
12/15	15" - 75'. WOC.
12/23	Anhy 890'? 10" - 908'. WOC.
12/30	Drlg. 2665'.
1939	
1/6	Fort Filey 1930'. Topeka 2860'. Lans. 3260'. Drlg. 3505'.
1/7	Top Conglomerate 3533 Top Arb. 3572 TD 3580 small show oil Will core (Tel)
1/10	Core 3580-85 T.D. Recovered 2' dolomite show oil Running 7" (Tel)
1/13	7" - 3575'. RUST.
1/18	Drilled plug Bailed 33 bbls. oil & 1/3 bbl. water 24 hrs. No water last 15 hrs. of test Grav. 32.1 Corr. Will acidize (Tel)
1/19	Acidized 1000 gallons Did not test Reacidized 3000 gallons (Tel)
1/24	Reacidized 2000 gallons Swab 38 bbls. fluid 24 hrs. 20% acid water Will deepen (Tel)

OVER

1939

1/27 Only treated with a total of
3000 acid. Swab 38 bbls. fluid
in 24 hrs., 20% acid water.
Deepened to 3611'.
Swab 2 oil per hour for 3 hrs.
Made 1/2 bailer wtr. &
Testing.

1/28--Bailed $2\frac{1}{2}$ bbls. water per hour 3611-15
and the hole filled 2600' with water
3615-21. T. D. 3632'.
Plugging back to 3595 to retest the oil
showing in the upper part of the
Arbuckle. (Letter from HDH)

2/3 2600' water 3615-21'.
T. D. 3632'.
P. B. to 3594'. WOC.

2/3--P.B. to 3594 Bailed 35 bbls. oil & bbl.
water 24 hrs. Installing pump (Tel)

2/10 Bailed 35 oil & 1 bbl. wtr. in
24 hrs. Now flowing 20 oil
per day by heads.

2/15 7" - 3575'.
Arb. 3572'.
T.D. 3632'.
H.F.W.
P. B. to 3595
3000 acid.
Potential 132 bbls.
Gravity 32.7

COMPLETED

Barton **KANSAS**Map No. 82 Sec. 14 Twp. 19 R. 15WWell No. 1 Olga KruckenberglAmerada CompanyWildcat Contractor

FIRST REPORT

SECTION PLAT

C NE NE

660 Ft. from N. Line

_____ Ft. from S. Line

660 Ft. from E. Line

_____ Ft. from W. Line

			0

Location _____

Rig up _____

Drilling and Remarks:

BRR

RECORD

Cased _____ in., _____ ft.

Sand _____

Gas _____

Oil _____

Total Depth _____

PRODUCTION

1st 24 hrs. Nat. _____

1st 24 hrs. after shot _____

Gas _____ Cu. Ft.

Dry Hole _____

Abandoned _____

Date

DEC 7 - 1938 19 H. D. Hatfield Scout

Map No. 82 Sec. 14 Twp. 19 R. 15WWell No. 1 Olga KruckenbergAmerada Company

Contractor

COMPLETED

C NE NE

660 Ft. from N. Line Ft. from S. Line660 Ft. from E. Line Ft. from W. Line**SECTION PLAT**

			0

WILDCAT

Location Rig up

Drilling and Remarks:

*HFW**P.B. 3595**3000 Acid**POT 132**gravel 32.7***RECORD**Cased 7 in., 3575 ft.Sand ATB 3572Gas Oil Total Depth 3632**PRODUCTION**1st 24 hrs. Nat. 1st 24 hrs. after shot Gas Cu. Ft.Dry Hole Abandoned

Date

FEB 15 1939 19 G. D. Hatfield Scout