


Section 14 Township 19 Range 15-W

Well No. 1 Merten

Company Amerada

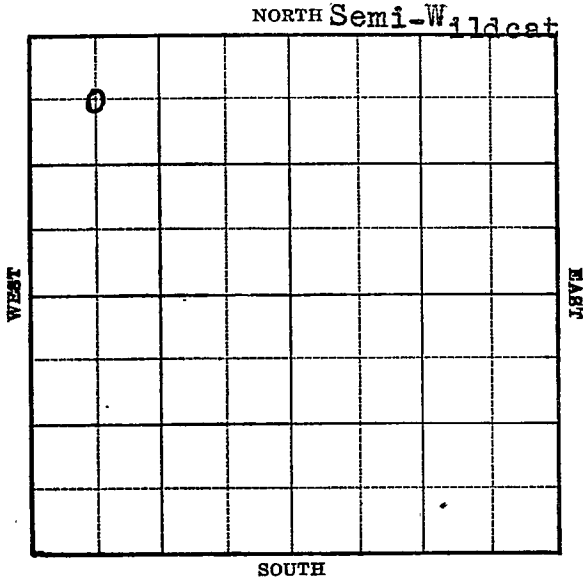

Sec. 14 Twp. 19 R. 15-WWell No. #1 Merten Farm _____

Amerada

Company _____

(Semi-Wildcat)


860 Ft. from N. Line

_____ Ft. from S. Line

_____ Ft. from E. Line

660 Ft. from W. Line

Elev. 1946

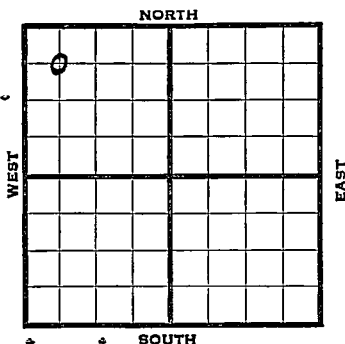

1939	REPORT
3/1	B. R. R.
3/10	15" - 84' WOC.
3/17	10" - 888' WOC.
3/24	Anhy. 885' Fort Riley 1900' Base Florence Flint 2040' Drlg. 2718'
3/31	Lans. 3204' S. G. 3286' S. O. & G. 3380-86' No Cong. or Arb. Quartzite 3460' T.D. 3470' S.D.O.
4/7	"
4/14	P. B. 3393' 7" - 3343' 2000 acid. Flow 110 oil in 4½ hours. Est. 5 M cu. ft. gas. Shut in pressure 1000# Gravity 27.4
	OVER

1939

4/19

7" - 3343'

Lans. 3204'

No arbuckle.

Quartzite 3460-70'

T. D. 3470'

P. B. to 3343'

Flow 146 oil in 8 hours.

Potential 437 bbls. Cut 8% wtr.

2 M cu. ft. gas.

Gravity 27.6

COMPLETED

Map No. 82 Sec. 14 Twp. 19 R. 15W

Well No. 1 Merten

Amerada

Company

Contractor

FIRST REPORT

SECTION PLAT

C NW NW

660 Ft. from N. Line

_____ Ft. from S. Line

_____ Ft. from E. Line

660 Ft. from W. Line

0			

SEMI-WILDCAT

Location _____

Rig up _____

Drilling and Remarks:

BRR

RECORD

Cased _____ in., _____ ft.

Sand _____

Gas _____

Oil _____

Total Depth _____

PRODUCTION

1st 24 hrs. Nat. _____

1st 24 hrs. after shot _____

Gas _____ Cu. Ft.

Dry Hole _____

Abandoned _____

Date

MAR 1 - 1939 19

H. D. Hatfield Scout

Barton

KANSAS

Map No. 82 Sec. 14 Twp. 19 R. 15W

Well No. 1 Merten

Amerada

Company

Contractor

COMPLETED

SECTION PLAT

C NW NW
660 Ft. from N. Line
 _____ Ft. from S. Line
 _____ Ft. from E. Line
660 Ft. from W. Line

0			

SEMI-WILDCAT

Location _____

Rig up _____

Drilling and Remarks:

*Lans 3204 No Arbutle
 Quartzite 3460-70 T.D. No oil
 P.B. 3395 2000 Acid
 7" 3343
 Flow 146 oil / 8 hrs
 Pot 437 cut 890 wtr
 2 M. Cu. Ft. gas
 grav 27.6*

RECORD

Cased 7 ins, 3343 ft.
 Sand _____
 Gas _____
 Oil _____
 Total Depth 3470

PRODUCTION

1st 24 hrs. Nat. _____
 1st 24 hrs. after shot _____
 Gas _____ Cu. Ft.
 Dry Hole _____
 Abandoned _____

Date

APR 19 1939 19

H. D. Hatfield

Scout