


KANSAS

Barton

Section 15 Township 19 Range 11WWell No. 1 BurkhardtCompany Lewis Drlg.

Latermann Pool

NORTH

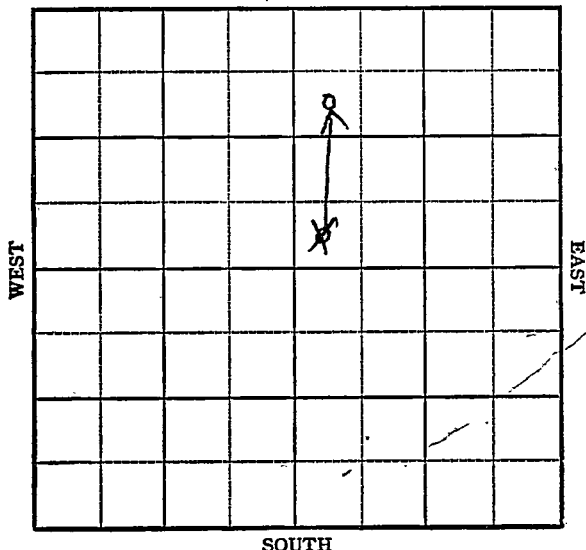

KANSAS

Barton

Sec. 15 Twp. 19 R. 11W

Well No. #1 Burkhardt Farm

Lewis Drlg.

Latermann Pool Company


990' Ft. from N. Line

330' Ft. from S. Line

\_\_\_\_\_ Ft. from E. Line

330' Ft. from W. Line

SW ~~NE~~ NW NE

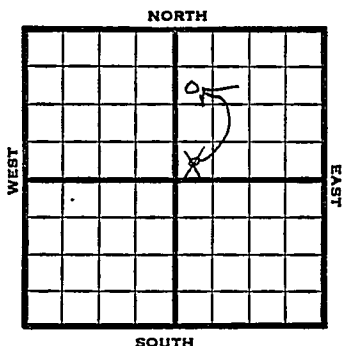

1948

Eli 1768'

R E P O R T

11/10

8" @ 183'

11/16

Lansing 3069'

Drlg. 3140'

11/23

TD 3378'

12/1

TD 3378'

Arb. 3376'


Aband.

**ABANDONED**

KansasMap No. \_\_\_\_\_ Sec. 15 Twp. 19 R. 11WWell No. 1 BurkhardtLewis Drlg. Company \_\_\_\_\_**FIRST REPORT**

Contractor \_\_\_\_\_

SW NE

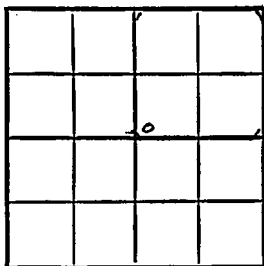**SECTION PLAT**

\_\_\_\_\_ Ft. from N. Line

330 Ft. from S. Line

\_\_\_\_\_ Ft. from E. Line

330 Ft. from W. LineBarton County

Location \_\_\_\_\_

Rig up \_\_\_\_\_

Drilling and Remarks:

8" @ 183

**RECORD**

Cased \_\_\_\_\_ in., \_\_\_\_\_ ft.

Sand \_\_\_\_\_

Gas \_\_\_\_\_

Oil \_\_\_\_\_

Total Depth \_\_\_\_\_

**PRODUCTION**

1st 24 hrs. Nat. \_\_\_\_\_

1st 24 hrs. after shot \_\_\_\_\_

Gas \_\_\_\_\_ Cu. Ft.

Dry Hole \_\_\_\_\_

Abandoned \_\_\_\_\_

Date

NOV 10 1948 19

S. J. LEWIS

Scout

Map No. 46 Sec. 15 Twp. 19 R. 11W

Well No. 1 Burkhardt

Lewis Drlg. Company

CORRECTION Contractor

SW NW NE


SECTION PLAT

990 Ft. from N. Line

         Ft. from S. Line

         Ft. from E. Line

330 Ft. from W. Line

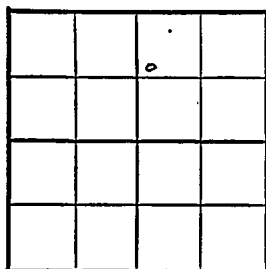

Barton Countv

Location                         

Rig up                         

Drilling and Remarks:

Reported

SW NE

RECORD

Cased          in.,          ft.

Sand                         

Gas                         

Oil                         

Total Depth                         

PRODUCTION

1st 24 hrs. Nat.                         

1st 24 hrs. after shot                         

Gas                          Cu. Ft.

Dry Hole                         

Abandoned                         

Date

NOV 17 1948 19 S. J. LEWIS Scout

Kansas

Map No. 46 Sec. 15 Twp. 19 R. 11WWell No. 1 BurkhardtLewis Drlg.

Company

**ABANDONED**


Contractor

SW NW NE

E11768  
**SECTION PLAT**990 Ft. from N. Line

Ft. from S. Line

Ft. from E. Line

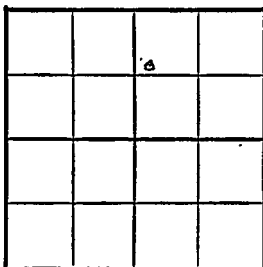330 Ft. from W. LineBarton County

Location

Rig up

Drilling and Remarks:

CR 82976**RECORD**

Cased \_\_\_\_\_ in., \_\_\_\_\_ ft.

Sand \_\_\_\_\_

Gas \_\_\_\_\_

Oil \_\_\_\_\_

Total Depth 2275**PRODUCTION**

1st 24 hrs. Nat. \_\_\_\_\_

1st 24 hrs. after shot \_\_\_\_\_

Gas \_\_\_\_\_

Cu. Ft. \_\_\_\_\_

Dry Hole \_\_\_\_\_

Abandoned \_\_\_\_\_

Date

DEC 1 1948S. J. LEWIS Scout