

KANSAS

Barton


FORM 51 5M 4-41 PETROL

Section 15 Township 19 Range 11-W

Well No. #3 Rehme

Company Lario Oil & Gas

NORTH **Lanterman Pool**

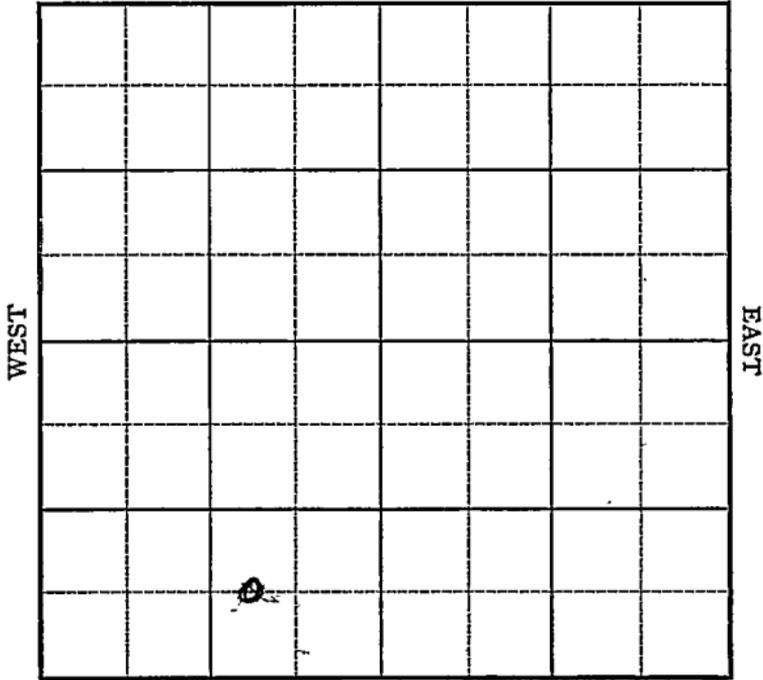

SOUTH

Sec. 15 Twp. 19 R. 11-W

Well No. #3 Rehme Farm

Lario Oil & Gas Company

(Lan termant)


_____ Ft. from N. Line

660 Ft. from S. Line

990 Ft. from E. Line

~~990~~ Ft. from W. Line

Elev. 1788

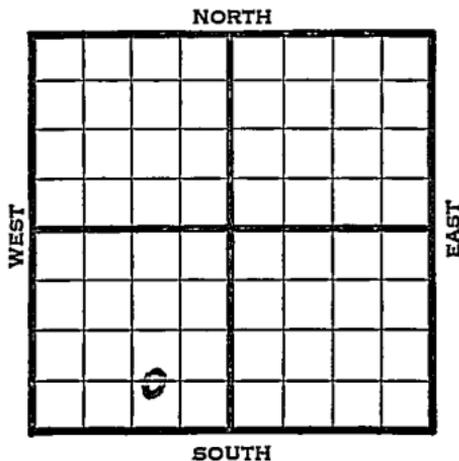

1941	REPORT
4/23	Location
5/1	Drlg. 272'
5/8	Drlg. 2185'
5/15	Arb. 3330½' 5" - 3331½' T.D. 3336' RUST.
5/22	T.D. 3348' 1350' oil 20 hours. 1000 acid.
5/28	" "
6/4	Arb. 3330½' 5" - 3331½'
	T.D. 3348' 1000 acid.
	Depthograph potential 6996 bbls.
	Maximum 3000 bbls.
	43.2 Gravity
	COMPLETED

Map No. 46 Sec. 15 Twp. 19 R. 11W

Well No. 3 Rehme

Lario Oil & Gas Company

COMPLETED Contractor

C W L SE SW

 Ft. from N. Line

660 Ft. from S. Line

990 Ft. from E. Line

 Ft. from W. Line

LANTERMAN POOL

SECTION PLAT

Location

Rig up

Drilling and Remarks:

Cu & 3330 1/2
5" @ 3331 1/2
1800 acid
D. H. R. 46996
Map 3000
48 E. G.

RECORD

Cased in., ft.

Sand

Gas

Oil

Total Depth: 3348

PRODUCTION

1st 24 hrs. Nat.

1st 24 hrs. after shot

Gas Cu. Ft.

Dry Hole

Abandoned

Date

JUN 4 1941 19

S. J. LEWIS

Scout

Misc. Small Maps	DAV
Cards	DAV
Tracing	DAV
France Map	DAV
Scarborough Map	DAV
Moody Map	DAV
Geological Dept.	
Moody Plat Book

Map No. 46 Sec. 15 Twp. 19 R. 11W

Well No. 3 Rehme

Lario Oil & Gas Company

correction Contractor

SECTION PLAT

C W L SE SW

_____ Ft. from N. Line

660 Ft. from S. Line

990 Ft. from E. Line

_____ Ft. from W. Line

LANTERMAN POOL

Location _____

Rig up _____

Drilling and Remarks:

RECORD

Cased _____ in., _____ ft.

Sand _____

Gas _____

Oil _____

Total Depth _____

PRODUCTION

1st 24 hrs. Nat. _____

1st 24 hrs. after shot _____

Gas _____ Cu. Ft.

Dry Hole _____

Abandoned _____

Date

MAY 7 1941

S. J. LEWIS Scout

11/10/03

0

2

Misc. Small Maps	
Cards	<i>Paul</i>
Tracing	<i>JM</i>
France Map	
Scarborough Map	
Moody Map	<i>JM</i>
Geological Dept.	
Moody Flat Book	

Map No. 46 Sec. 15 Twp. 19 R. 11W

Well No. 3 Rehme

Lario Oil & Gas Company

FIRST REPORT Contractor

SECTION PLAT

C W L SE SW

_____ Ft. from N. Line

660 Ft. from S. Line

_____ Ft. from E. Line

990 Ft. from W. Line

	o		

LANTERMAN POOL

Location X

Rig up _____

Drilling and Remarks:

RECORD

Cased _____ in., _____ ft.

Sand _____

Gas _____

Oil _____

Total Depth _____

PRODUCTION

1st 24 hrs. Nat. _____

1st 24 hrs. after shot _____

Gas _____ Cu. Ft.

Dry Hole _____

Abandoned _____

Date

APR 23 1941 19

S. J. LEWIS Scout

Don - I think ft. meas. are incorrect -
Pittman

Misc. Small Maps	✓
Cards	✓
Tracing	✓
France Map	✓
Scarborough Map	✓
Moody Map	✓
Geological Dept.	
Moody Flat Book	