


Section 15 Township 19 Range 11 W

Well No. # 4 Rehme

Company Lario Oil et al

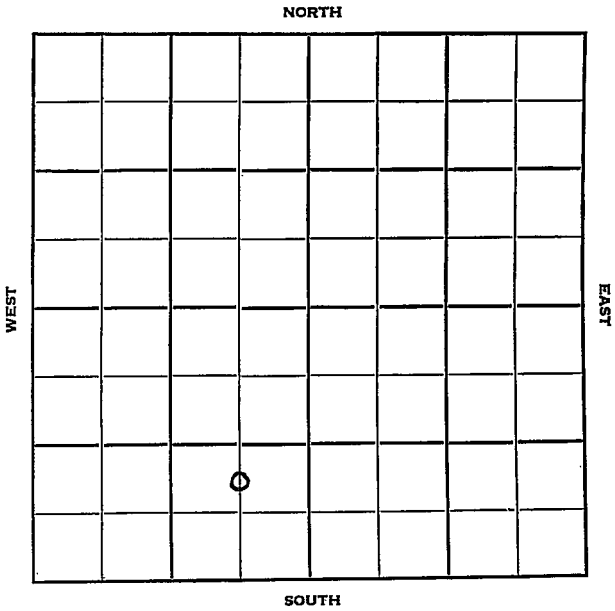

Sec. 15 Twp. 19 R. 11W

Well No. #4 Rehme Farm

Lario Oil et al Company

Lewis Drilg. - Contr. Contractor


\_\_\_\_\_ Ft. from N. Line

990' Ft. from S. Line

660' Ft. from E. Line

\_\_\_\_\_ Ft. from W. Line

C N L SE SW

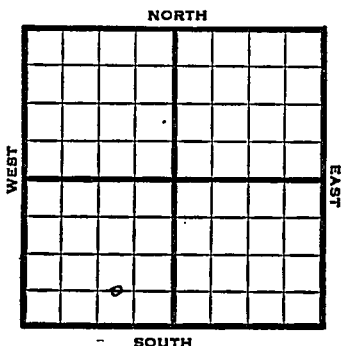

1951

Elev. 1787' REPORT

3/7

RUR

4/11

Spud 3-7-51

Oil Well TD 3360

10" @ 265'

Anhy 560' Top. 2667

Heeb. 2915 Br Lime 3035

Lans. 3053 Re Arb. 3337

Solid Arb. 3346-54 TD

7" @ 3348 500 A S/2 boph DD 3360

S/2 1/2 boph 1000 A S/8 boph

P/10 boph Comp. 80 bopd 60 bw

COMPLETED

County Barton State Kansas

Sec. 15 (Blk. 19 (Sur. 11W Twp.) Rge.) Map No.

Operator Lario Oil etal.

Well No. 4 Farm Rehme

Elev. \_\_\_\_\_ Location C N L SE SW

|  |  |  |  |  |  |
|--|--|--|--|--|--|
|  |  |  |  |  |  |
|  |  |  |  |  |  |
990 Ft. From S Line SW

660 Ft. From E Line Quarter

Ist. Report MAR 7 1951

Completion \_\_\_\_\_

Remarks \_\_\_\_\_

Lewis Drlg. - Contr.

Spudding Date \_\_\_\_\_

Drlg. Data \_\_\_\_\_

R U R

