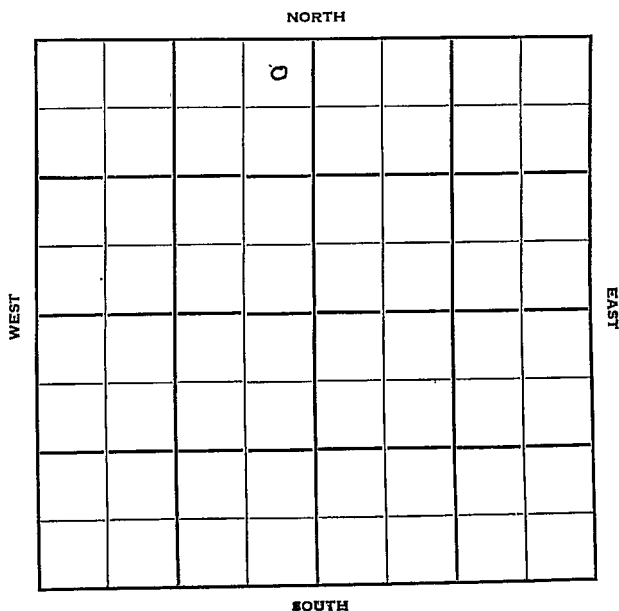


Section 15 Township 19 Range 12-WWell No. #1 SchartzCompany Alpine Oil & Royalty

Barton

KANSAS

Sec. 15 Twp. 19 R. 12W

Well No. #1 Schartz Farm

Alpine Oil & Royalty Company

Contractor

Wildcat

330' Ft. from N. Line


Ft. from S. Line

330' Ft. from E. Line

Ft. from W. Line

NE NE NW

Oil Well

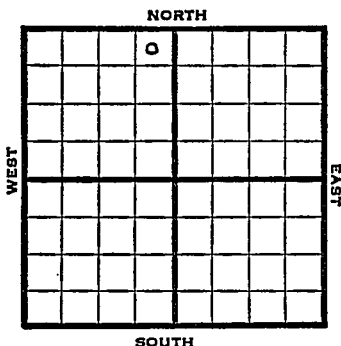

1950

Elev 1844

REPORT

7/5

Spud 7-2-50

8" @ 240

WOC

9/13

8" @ 240

Br line 3130

Lans 3149

DST 3150-3222 op 45 min rec 1060' ocm

Cong 3420-46

5" @ 3445

40/3167-75

700 A F/50 boph 4 hr

Comp 282 bopd

TD 3446

Completed

COMPLETED


Map No. _____ Sec. 15 Twp. 19 R. 12WWell No. 1 ScharitzAlpine Oil & Royalty Company_____
Contractor

NE NW

SECTION PLAT

330 Ft. from N. Line_____
Ft. from S. Line330 Ft. from E. Line_____
Ft. from W. Line

Barton County

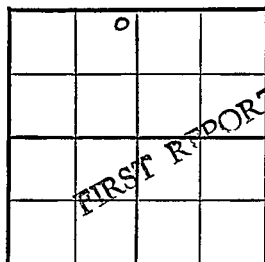

Location _____

Rig up _____

Drilling and Remarks:

Spud 7-2-50

8" @ 240

WOC

RECORD

Cased _____ in., _____ ft.

Sand _____

Gas _____

Oil _____

Total Depth _____

PRODUCTION.

1st 24 hrs. Nat. _____

1st 24 hrs. after shot _____

Gas _____ Cu. Ft.

Dry Hole _____

Abandoned _____

Date

JUL 5 1950 19J. E. TYRA

Scout

