

Section 15 Township 19 Range 12W

Well No. #2 Pfluge

Company Geo. Hannum

NORTH

							0

16

WEST

EAST

SOUTH

Barton KANSAS


Sec. 15 Twp. 19 R. 12W

Well No. #2 Pfluge Farm

Geo. Hannum Company

North Hammer Pool Contractor

Ft. from N. Line
990' Ft. from S. Line
330' Ft. from E. Line
Ft. from W. Line

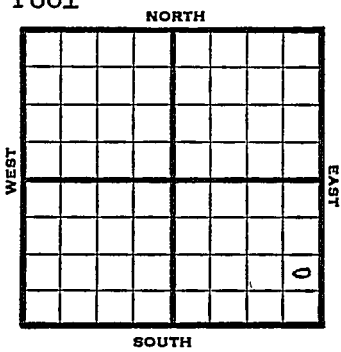

NE SE SE

1950 Elev 1864 REPORT

10/11 Cellar & Pits

11/22 Spud 10-10-50
 8" @ 283
 Anhy 676-705 Heeb 3031
 Br line 3147 Lans 3162
 DST 3164-3216 opn 15 min rec 200' ho
 & gcm
 Cong 3435 Arg 3450-58
 5" @ 3456
 TD 3479
 500 A
 SP 3407
 24/3182-90
 SO 24/3175-83
 24/3155-63
 SO
 1000 A
 S/8 boph
 Comp 164 bopd
 Completed
COMPLETED

