

Section 15 Township 19 Range 12W

Well No. #4 Schartz "A"

Company Lewis Drlg.

NORTH

				0			

WEST

EAST

SOUTH

7

Sec. 15 Twp. 19 R. 12W

Well No. #4 Schartz "A" Farm

Lewis Drlg. Company

Lewis Drlg. - Contr. Contractor

Cheyenne View Pool


 Ft. from N. Line

330 Ft. from S. Line

 Ft. from E. Line

330' Ft. from W. Line

SW SW NE

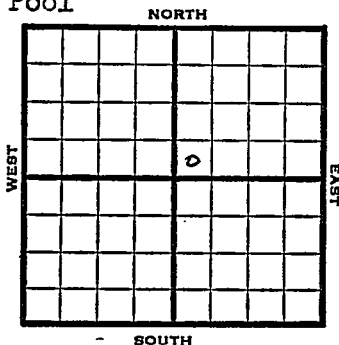

1950

Elev. 1847

REPORT

12/6

Location

1951

1/31

Spud 12/7/50

Oil well TD 3440

8" @154

Anhy 668-70 Heeb. 3023 Br. lime 3137

Lans. 3152 Cong. 3427

SO 3430-39 TD 3440

5" @3430

FU 2200' oil 20 qt/ on bottom 3 boph

Comp. 286 bopd

COMPLETED

