

Rice

Map No. KANSAS Sec. 15 Twp 19 R. 10 ^W

Well No. 1 Gill Farm


Shelly Company

660 Ft. from N. Line

_____ Ft. from S. Line

440 Ft. from E. Line

_____ Ft. from W. Line

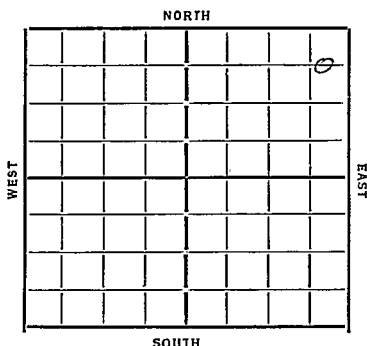

Date	REPORT
<u>1933</u>	<u>E. 1753</u>
<u>12/20</u>	<u>Bldg Rcy</u>
<u>12/27</u>	<u>cellar</u>
<u>1/11</u>	<u>15" at 151 Wreg 330</u>
<u>1/17</u>	<u>T.D. 925 - S.D Repairs</u>
<u>1/24</u>	<u>Wreg 1850</u>
<u>1/31</u>	<u>" 2455 10" 1990</u>
<u>2/7</u>	<u>KC Lime 2935 show gas 2942</u>
	<u>Run 6" 2958</u>
<u>2/14</u>	<u>Show oil 2996 HFW 3033-39</u>
	<u>Bailing</u>
<u>2/23</u>	<u>Correction 3171 = 3169 Wreg 3289</u>
<u>3/1</u>	<u>5" 3277 Sil line 3277 1/2 KC</u>
<u>3/8</u>	<u>75 3314 1/2 Bailed oil per</u>
	<u>hr acidizing</u>
<u>3/15</u>	<u>PB 3300 before acidizing</u>
	<u>No test</u>
<u>3/22</u>	<u>PB 3022 acidizing</u>
<u>4/4</u>	<u>Siliceous 3277 TD 3314</u>
	<u>KC Lime 2935 KC L</u>
	<u>acidized Siliceous acidized</u>
	<u>D & F</u>
	ABANDONED

Map No. 46 Sec. 15 Twp. 19 R. 10WWell No. 1- HillSpilly oil Company

Contractor

ABANDONED

SECTION PLAT

660 Ft. from N. Line

Ft. from S. Line

440 Ft. from E. Line

Ft. from W. Line

			0

Location

Rig up

Drilling and Remarks:

K.C. time 2935K.C. L. Acidized
SiliciousW & F

RECORD

Cased _____ in. _____ ft.

Sand Silicious 3277

Gas _____

Oil _____

Total Depth 3314

PRODUCTION

1st 24 hrs. Nat. _____

1st 24 hrs. after shot 2150

Gas _____ Cu. Ft.

Dry Hole _____

Abandoned _____

Date

4-4-34 192 O. Marnschke Scout

Map No. 46 Sec. 15 Twp. 19 R. 10WWell No. 1- HillSkelly Oil Company

Contractor

FIRST REPORTS**SECTION PLAT**660 Ft. from N. Line

			0

Ft. from S. Line

440 Ft. from E. Line

Ft. from W. Line

Location

Rig up

Drilling and Remarks:

B. R.**RECORD**

Cased.....in.,ft.

Sand.....

Gas.....

Oil.....

Total Depth.....

PRODUCTION

1st 24 hrs. Nat.....

1st 24 hrs. after shot.....

Gas.....Cu. Ft.

Dry Hole.....

Abandoned.....

Date

12-20-33 O. Manschreck Scout