


Section 15 Township 19 Range 10-W

Well No. #3 Feldman

Company Branine & Holl

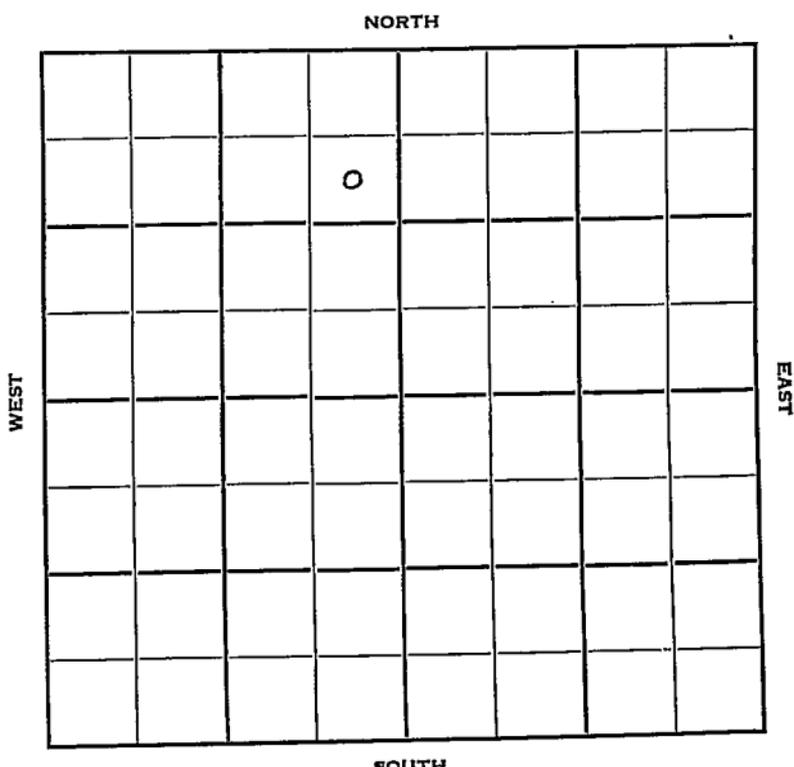

Sec. 15 Twp. 19 R. 10W

Well No. #3 Feldman Farm

Branine & Holl Company

Herndon Drlg. Contractor


990' Ft. from N. Line

Ft. from S. Line

330' Ft. from E. Line

Ft. from W. Line

SE NE NW

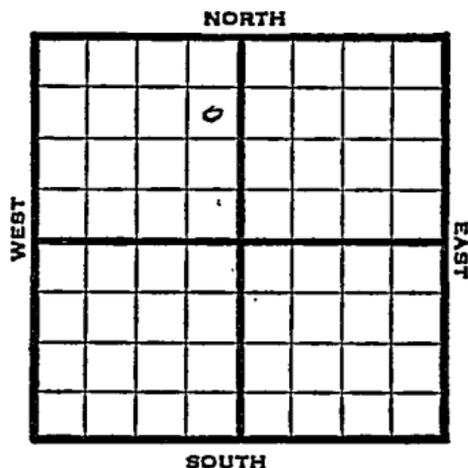

1950

Elev 1756

REPORT

6/14 Spud 6-11-50
8" @ 226'

7/19 Heeb 2799 Br line 2916

Lans 2946
SSO 3034-47
3020-24

Arb 3275-3312

Cong 3263
24/3288-90
Comp 50-60 bopd
TD 3312
Completed

COMPLETED

Kansas

Map No. _____ Sec. 15 Twp. 19 R. 10W

Well No. 3 Feldman

Branine & Holl Company

Herndon Drlg. Contractor

SE NE NW


990 Ft. from N. Line

_____ Ft. from S. Line

330 Ft. from E. Line

_____ Ft. from W. Line

SECTION PLAT

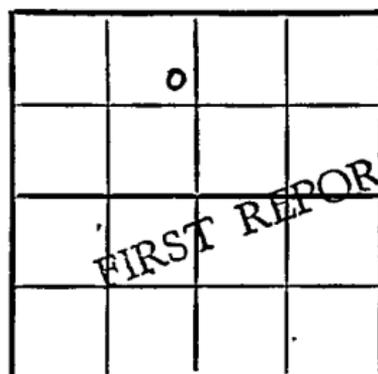

Rice County

Location _____

Rig up _____

Drilling and Remarks:

Spud 6-11-50

8" @ 226

RECORD

Cased _____ in., _____ ft.

Sand _____

Gas _____

Oil _____

Total Depth _____

PRODUCTION

1st 24 hrs. Nat. _____

1st 24 hrs. after shot _____

Gas _____ Cu. Ft.

Dry Hole _____

Abandoned _____

Date

JUN 14 1950 19

J. E. TYRA Scout

2 1 2 3 


22 74

11

270 1100

270 3 11

270 1100

 

270 1100

- Scout Cards
- Land Small Map
- Land Wall Map
- Tracings
- France Map
- Pierce Map
- Misc.

NOV 15 1950

39

Kansas

Map No. _____ Sec. 15 Twp. 19 R. 10W

Well No. 3 Feldman

_____ Branine & Holl _____ Company

_____ Contractor

SE NE NW


**El. 1756
SECTION PLAT**

990 Ft. from N. Line

_____ Ft. from S. Line

330 Ft. from E. Line

_____ Ft. from W. Line

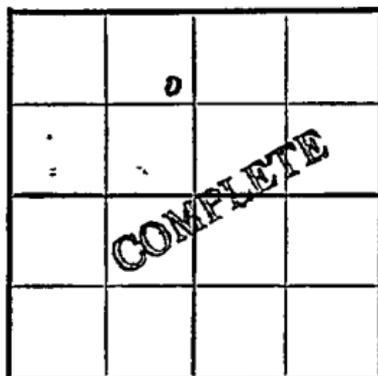

Rice County

Location _____

Rig up _____

Drilling and Remarks:

Heeb. 2799

Br. lime 2916

Lans. 2946

SSO 3034-47

3120-24

Cong. 3263

Arb. 3275-3312

RECORD

Cased _____ in., _____ ft.

Sand _____

Gas _____

Oil _____

Total Depth 3312

PRODUCTION

1st 24 hrs. Nat. _____

1st 24 hrs. after shot _____

Gas _____ Cu. Ft.

Dry Hole _____

Abandoned _____

24/ 3288-90

Date Comp. 50-60 bopd

JUL 19 1950

J. E. TYRA

19

Scout

