

Rice

KANSAS

Section 15 Township 19 Range 10 W

Well No. # 6 Feldman

Company Martin Wunderlick

NORTH

0							

WEST

EAST

SOUTH

Rice KANSAS


Sec. 15 Twp. 19 R. 10 W

Well No. # 6 Feldman Farm

Martin Wunderlick Company

Chase-Silica Pool Contractor

Ft. from N. Line
330 Ft. from S. Line
Ft. from E. Line
330 Ft. from W. Line

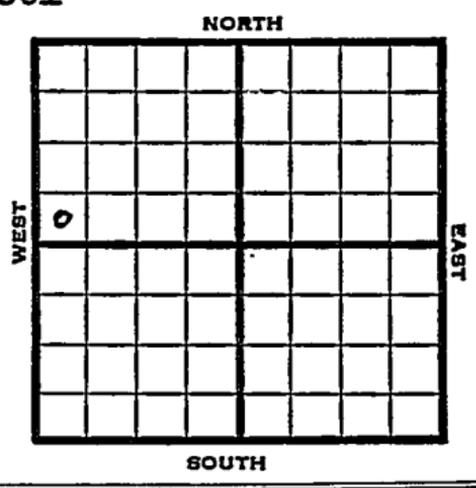

SW SW NW

1951 Elev. 1755' REPORT

12/12 Spud 12-3-51
8" @ 200
Drlg. 2975'

1952
1/9 Spud 12-3-51
Oil Well TD 3320
8" @ 200
Heeb. 2807
Br Lime 2928
Lans. 2953
Cong. 3268
Arb. 3298
TD 3320 5" @3317
24/3039-45 1000 A S/9 1/2 boph
Comp. 60 bopd 30% wtr.

COMPLETED

County **Rice** State **Kansas**

Sec. **15** (Blk. Twp.) **19** (Sur. Rge.) **10W** Map No.

Operator **Martin Wunderlink**

Well No. **6** Farm **Feldman**

Elev. Location **SW SW NW**

330 Ft. From **S** Line **NW**

330 Ft. From **W** Line **Quarter**

Ist. Report **DEC 1 2 1951**

Completion

Remarks

Spudding Date **12-3-51**

Drlg. Data **Chase - Silica Pool**

8" @ 200 drlg. **2975**

J. E. TYRA

