


Section 15 Township 19 Range 10 W

Well No. # 7 Feldman

Company Martin Wunderlich

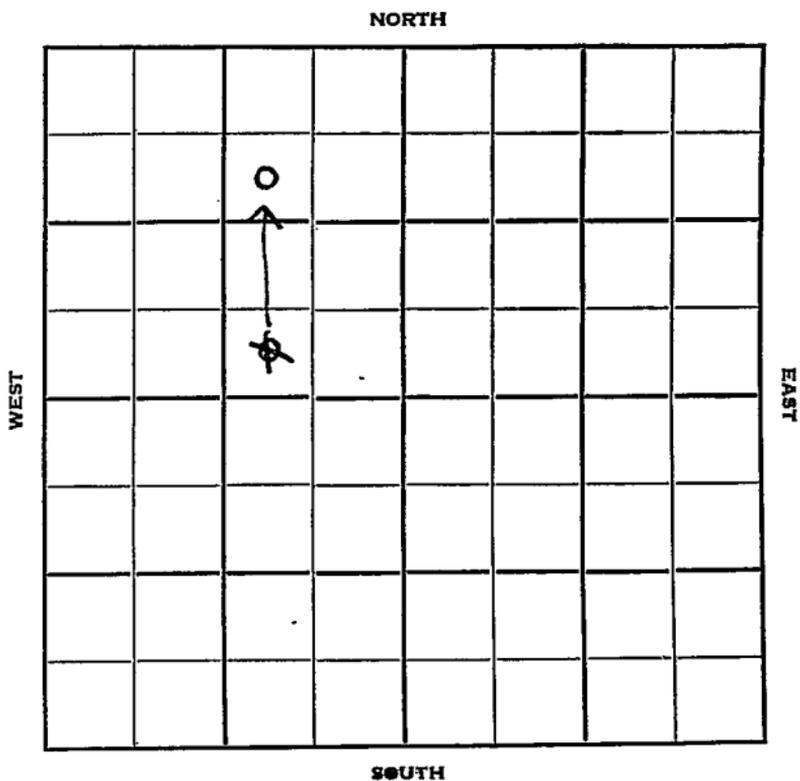

Rice KANSAS

Sec. 15 Twp. 19 R. 10 W

Well No. # 7 Feldman Farm

Martin Wunderlich Company

Williams Contractor


Chase-Silica Pool

990 Ft. from N. Line

~~330~~ Ft. from S. Line

990 Ft. from E. Line

_____ Ft. from W. Line

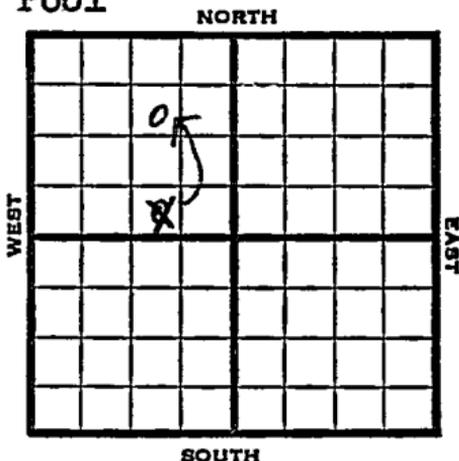

~~SW NE NW~~
~~SW SE NW~~

1951

Elev. 1754'

REPORT

12/12

Set surface

1952'

1/9

Spud 12-11-51

Oil Well TD 3210

8" @ 210

Heeb. 2810

Br Lime 2932

Lans: 2954

TD 3210

5" @ 3210

24/3045-59 1000 A S/12 boph

Comp. 80 bopd

COMPLETED


County **Rice** State **Kansas**

Sec. **15** (Blk. Twp.) **19** (Sur. Rge.) **10W** Map No.

Operator **Martin Wunderlich**

Well No. **7** Farm **Feldman**

Elev. Location **SW SE NW**

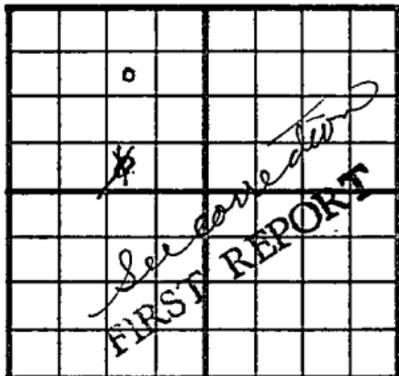

330 Ft. From **S** Line **NW**

990 Ft. From **E** Line **Quarter**

1st. Report: **DEC 1 2 1951**

Completion

Remarks

Williams - Contr.

Spudding Date

Drlg. Data **Chase - Silica Pool**

Set surface

J. E. TYRA

Map No. _____ Sec. 15 Twp. 19 R. 10W

Well No. 7 Feldman

Martin Wunderlich Company

CORRECTION

Contractor

SW NE NW

SECTION PLAT

990 Ft. from N. Line

_____ Ft. from S. Line

990 Ft. from E. Line

_____ Ft. from W. Line

	o		

Rice County

Location _____

Rig up _____

Drilling and Remarks:

Reported

SW SE NW

RECORD

Cased _____ in., _____ ft.

Sand _____

Gas _____

Oil _____

Total Depth _____

PRODUCTION

1st 24 hrs. Nat. _____

1st 24 hrs. after shot _____

Gas _____ Cu. Ft.

Dry Hole _____

Abandoned _____

Date

DEC 1 9 1951 19

J. E. TYRA Scout

County Rice State Kansas

Sec. 15 (Blk. 19) (Sur. 10W) (Twp.) (Rge.) Map No.

Operator Martin Wunderlich

Well No. 7 Farm Feldman

Elev. 1754 Location SW NE NW

990 Ft. From N Line NW

990 Ft. From E Line Quarter

1st. Report

Completion JAN 9 1952

Remarks Chase-Silica Pool
Williams - Contr.

Spudding Date 12-11-51

Drlg. Data Oil well TD 3210

8" @ 210 Heeb. 2810 Br. lime 2932

Lans. 2954 TD 3210 5" @ 3210

24/ 3045-59 1000 A S/ 12 boph

Comp. 80 bopd

J. E. TYRA