


Rice

KANSAS

Section 15 Township 19 Range 10 WWell No. # 8 FeldmanCompany Martin Wunderlich

NORTH

WEST

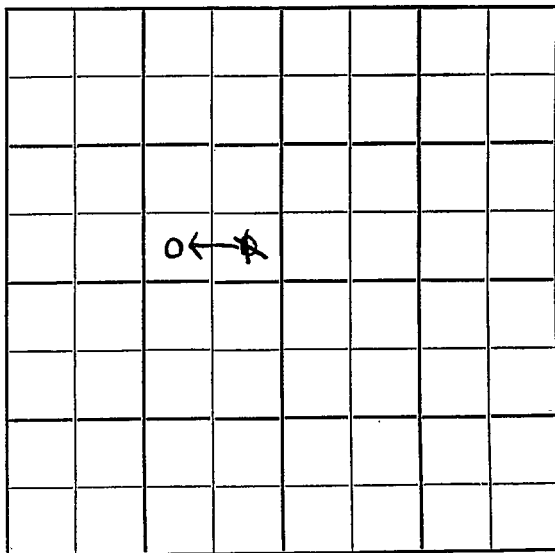

EAST

SOUTH

Rice

KANSAS

Sec. 15 Twp. 19 R. 10 W

Well No. # 8 Feldman Farm

Martin Wunderlich Company

Williams Contractor


Chase-Silica Pool

 Ft. from N. Line

330 Ft. from S. Line

990
330 Ft. from E. Line

 Ft. from W. Line

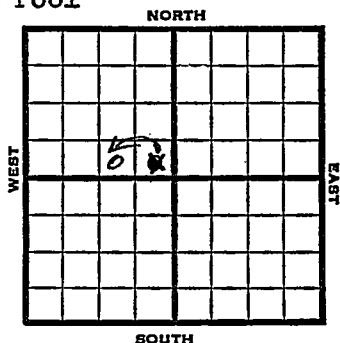

SW SE NW
SE SE NW

1951

Elev. 1758' REPORT

12/12

Set surface

1952

2/6

Spud 12-27-51

8" @ 207' Heeb 2810' Br. line 2929'

Lans. 2955' Cong. 3266' Arb. 3287'


TD 3290' 5" @ 3288' DD 3293'

300 A S/12 BOPH

Comp. 25 BOPD

COMPLETED

County Rice State Kansas
 Sec. 15 (Blk. Twp.) 19 (Sur. Rge.) 10W Map No. _____
 Operator Martin Wunderlich
 Well No. 8 Farm Feldman
 Elev. _____ Location SE SE NW

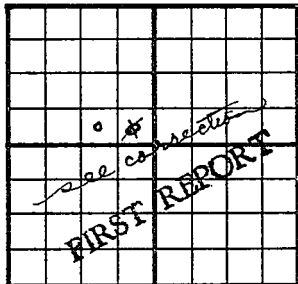

330 Ft. From S Line NW
330 Ft. From E Line Quarter
 Ist. Report DEC 1 2 1951
 Completion _____
 Remarks Williams - Contr.
 Spudding Date _____

Drlg. Data Chase - Silica Pool

Set surface

J. E. TYRA

Kansas

Map No. _____ Sec. 15 Twp. 19 R. 10WWell No. 8 Feldman

_____ Martin Wunderlich _____ Company

_____ **CORRECTION** _____ Contractor


SW SE NW

SECTION PLAT

_____ Ft. from N. Line

330 Ft. from S. Line990 Ft. from E. Line

_____ Ft. from W. Line

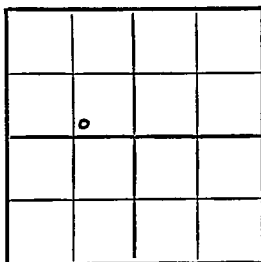

Rice County

Location _____

Rig up _____

Drilling and Remarks:

Reported

SE SE NW

RECORD

Cased _____ in., _____ ft.

Sand _____

Gas _____

Oil _____

Total Depth _____

PRODUCTION

1st 24 hrs. Nat. _____

1st 24 hrs. after shot _____

Gas _____ Cu. Ft.

Dry Hole _____

Abandoned _____

Date

DEC 19 1951

19

J. E. TYRA

Scout

County Rice State Kansas

Sec. 15 (Blk. Twp.) 19 (Sur. Rge.) 10W Map No.

Operator Martin Wunderlich

Well No. 8 Farm Feldman

Elev. 1758 Location SW SE NW

330 Ft. From S Line NW

990 Ft. From E Line Quarter

1st. Report

Completion **FEB 6 1952**

Remarks Chase-Silica Pool

Williams - Contr.

Spudding Date 12-27-51

Drig. Data

8" @ 207 Heeb. 2810 Br. lime 2929

Lans. 2955 Cong. 3266 Arb. 3287

TD 3290 5" @ 3288 DD 3293 300 A

S/ 12 bopd Comp. 25 bopd

J. G. McGEHEE