


Section 15 Township 19 Range 10W

Well No. #4 Feldman

Company Branine & Hall

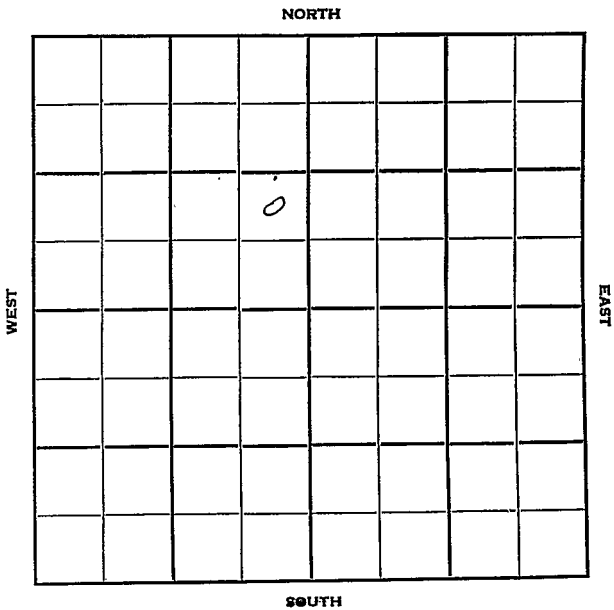

Rice

KANSAS

Sec. 15 Twp. 19 R. 10 W ✓

Well No. # 4 Feldman Farm

Branine & Hall Company

Atlas Contractor

Silicia Pool


Ft. from N. Line

990 Ft. from S. Line

330 Ft. from E. Line

Ft. from W. Line

NE SE NW

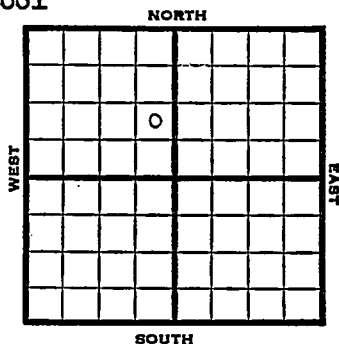

-- 2"
- 1- 1/2" h

1951

Elev. 1754' REPORT

6/13

Spud 6-7-51

8" @ 184

7/11

Drilling 2593'

Spud 6-7-51

Oil Well TD 3291

8" @ 184

Heeb. 2800 Tor. 2821

Br Lime 2917 Lans. 2942

SO 2962-67 3033-48

DST 3027-39 opn 1/2 hr

Rec. 960' gas 60' o & gcm

BKC 3205 Cong. 3256

Arb. 3278 TD 3291

5" @ 3288 S/15 boph 20% wtr

Comp. 100 bopd 20% wtr

COMPLETED

County Rice State Kansas
 Sec. 15 (Blk.) 19 (Sur.) 10W Map No.
 Operator Branine & Hall
 Well No. 4 Farm Feldman
 Elev. Location NE SE NW

990 Ft. From S Line NW
 330 Ft. From E Line Quarter
 1st. Report JUN 13 1951

Completion

Remarks

Atlas - Contractor

Spudding Date 6-7-51


Drlg. Data

8" @ 184 Drilling 2593

Silicia Pool

J. E. TYRA

County Rice State KANSAS
 Sec. 15 (Blk. 19 (Sur. 10W Map No.
 (Twp.) (Rge.)
 Operator Branine & Holl
 Well No. 4 Farm Feldman
 Elev. 1754 Location NE SE NW

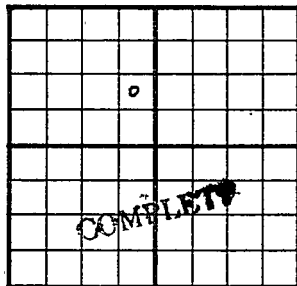

990 Ft. From S Line NW
330 Ft. From E Line Quarter

Ist. Report

Completion JUL 11 1951

Remarks Silica Pool

Atlas - Contr.

Spudding Date 6-7-51

Drlg. Data Oil well TD 3291
8" @ 184 Heeb. 2800 Tor. 2821
Br. lime 2917 Lans. 2942 SO 2962-
67 3033-48 DS¹ 3027-39 open $\frac{1}{2}$ hr
Rec. 960' gas 60' o & gcm B KC 3205
Cong. 3256 Arb. 3278 TD 3291
5" @ 3288 S/ 15 boph 20% water
Comp. 100 boph 20% water

J. E. TYRA