

McPherson


DX 78-1

KANSAS

Section 15 Township 19 Range 2W

Well No. #1 Koehn

Company Slusser Drlg.

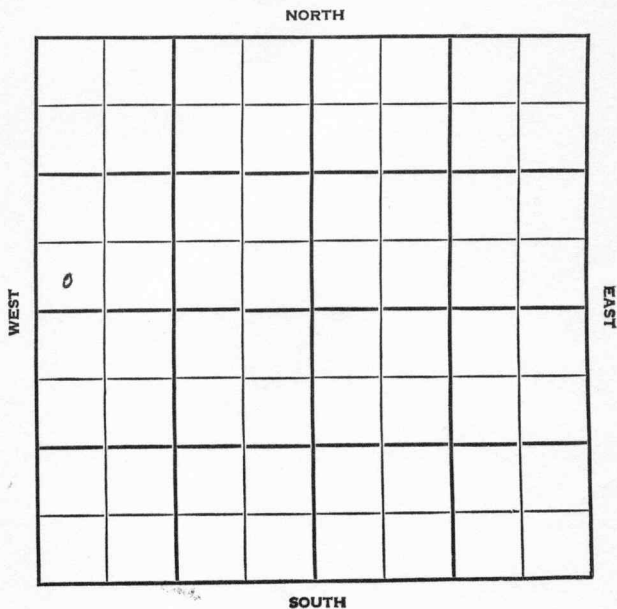

SEC.	TWP.	R.
15	19	2W

WELL NO.

#1 Koehm

FARM

COMPANY

Slusser Drlg.

CONTRACTOR

Co. Tools.

Ritz-Canyon Pool

NORTH

Ft. from N. Line

330

Ft. from S. Line

Ft. from E. Line

330

Ft. from W. Line

WEST

EAST

SOUTH


SW SW NW

	ELEVATION	REPORT
1954	1548'	

12/15 Spud 12-9-54
8" @ 162'
Drlg. 2096'

1955
1/12 Spud 12-9-54 - D&A
TD 2971'
8" @ 162'
Miss 2918'
TD 2927'
5" @ 2927'
DD 2971'
S/15 bwph SSO&G
D&A

ABANDONED

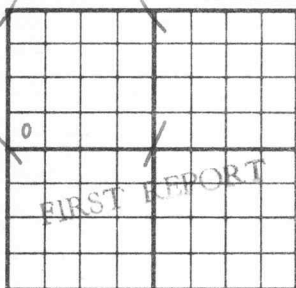County **McPherson** State **Kansas**Sec. **15** (Blk. **19** (Sur. **2W** Map No. **2W**)
(Twp.) (Rge.)Operator **Slusser Drlg.**Well No. **1** Farm **Koehn**Elev. Location **SW SW NW****330** Ft. From **S** Line **NW****330** Ft. From **W** Line Quarter1st. Report **DEC 15 1954**

Completion

Remarks

Co. toolsSpudding Date **12-9-54**Drlg. Data **Ritz-Canton Pool****8" @ 162 drlg. 2096**

GILSTRAP

County McPherson State KansasSec. 15 (Blk. Twp.) 19 (Sur. Rge.) 2W Map No.Operator Slusser Drlg.Well No. 1 Farm KoehnElev. 1548 Location SW SW NW330 Ft. From S Line NW330 Ft. From W Line Quarter1st. Report JAN 1 2 1955

Completion

Remarks Ritz-Canton PoolCo. toolsSpudding Date 12-9-54Drlg. Data D & A TD 29718" @ 162 Miss. 2918 TD 2927 5" @ 2927DD 2971 S/ 15 bwph SSO & GD & A

FABEN GILSTRAP