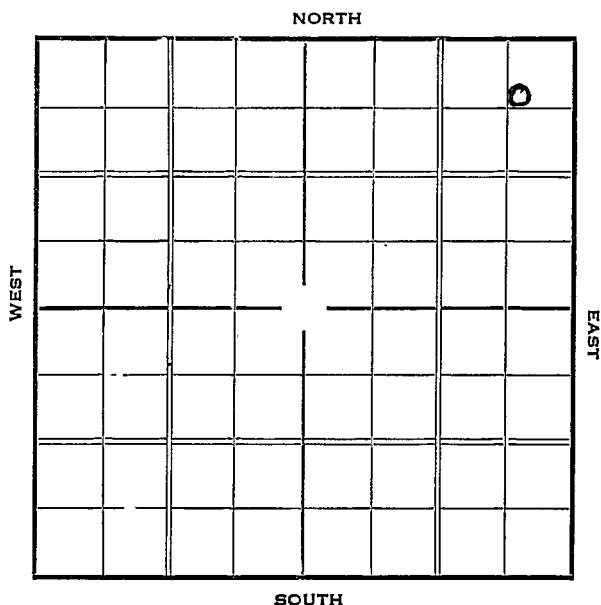


KANSAS

McPherson


Section 15 Township 19 Range 2-WWell Number 2 LindbergCompany Shell

Sec. 15 Twp. 19 R. 2-WWell No. #2 Lindberg FarmShell

Company

658 Ft. from N. Line Ft. from S. Line650 Ft. from E. Line Ft. from W. Line

Elev. 1557

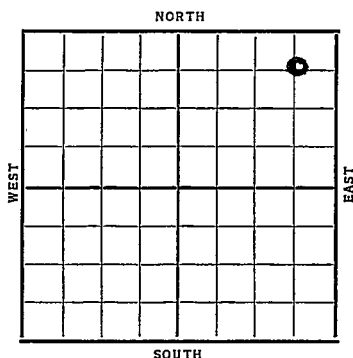

Date	REPORT
1937	
3/24	Rig
4/2	Rigging up.
4/8	13" @ 174' Drlg. 1233'
4/16	Drlg. 2812'.
4/23	Chat 2914'. RUST.
4/30	5" @ 2912'. Some oil 2945-48
	T.D. 2956'. 2000 acid.
	Testing.
5/7	Pump 10 oil 52 water 10 hrs
5/14	Pump 10 oil 65 wtr. 24 hrs.
5/19	5" @ 2912'.
	Chat 2914'.
	T.D. 2956'.
	2000 acid.
	Pumped, Potential 10 bbls.
	oil & 65 bbls. water.
	COMPLETED

KANSAS *McPherson*Map No. *43* Sec. *15* Twp. *19* R. *2W*Well No. *2. Lindberg**Shell* Company

Contractor

SECTION PLAT

			0

658 Ft. from N. Line

_____ Ft. from S. Line

650 Ft. from E. Line

_____ Ft. from W. Line

FIRST REPORT

Location _____

Rig up _____

Drilling and Remarks:

Rig

RECORD

Cased _____ in., _____ ft.

Sand _____

Gas _____

Oil _____

Total Depth _____

PRODUCTION

1st 24 hrs. Nat. _____

1st 24 hrs. after shot _____

Gas _____ Cu. Ft.

Dry Hole _____

Abandoned _____

Date

MAR 24 1937

19

S. J. LEWIS Scout

KANSAS

Mc Pherson

Map No. 43 Sec. 15 Twp. 19 R. 2^WWell No. 2 - LindbergShell Company

Contractor

COMPLETED

SECTION PLAT

			0

658 Ft. from N. Line

Ft. from S. Line

658 Ft. from E. Line

Ft. from W. Line

RECORD

Location _____

Cased 5 in., 2912 Ft.

Rig up _____

Sand Chat - 2914

Drilling and Remarks:

Gas _____

2000 acid

Oil _____

Total Depth 2956

PRODUCTION

1st 24 hrs. Nat. _____

1st 24 hrs. after shot _____

Gas _____ Cu. Ft.

Dry Hole _____

Abandoned _____

Pumped
Pot 10 oil
65 water

Date

MAY 19 1937 19

H. D. Hatfield Scout.