

McPherson


KANSAS

SECTION 15 TOWNSHIP 19S RANGE 2W

WELL NO. #2 S.A. Lindberg

COMPANY J.S. Cling

NORTH C S/2 S/2 NE

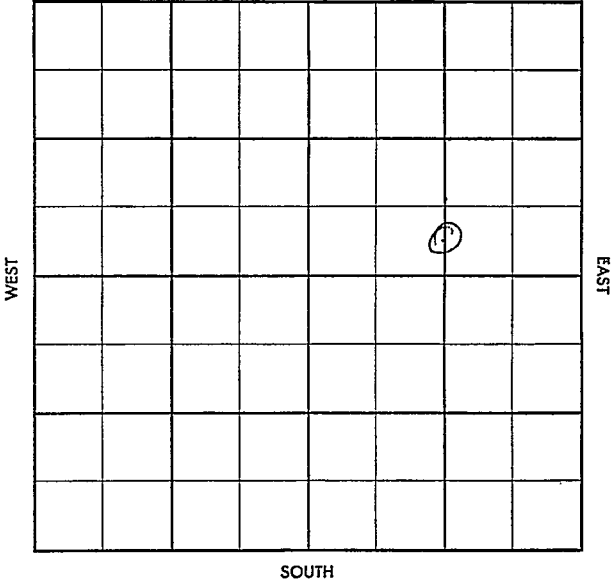

CO. McPherson ELEV. _____

SEC. 15 TWP. 19 RGE. 2W

COMPANY J. S. Cling NO. 2

JAN	2	'58	
			o
FIRST REPORT			

FARM S. A. Lindberg

LOC. C S/2 S/2 NE

GEOL. _____

CONTR. Slusser Drlg.

POOL Ritz Canton

SPUD _____

Location _____

[Handwritten signature]

CO.
LSE.
NO.
SEC.
TWP.
RGE.

