

McPherson

KANSAS

15

19

2W


SECTION _____ TOWNSHIP _____ RANGE _____

WELL NO. #4 Salthouse

COMPANY Francis O. Hawn etal

NORTH

C N/2 N/2 SE

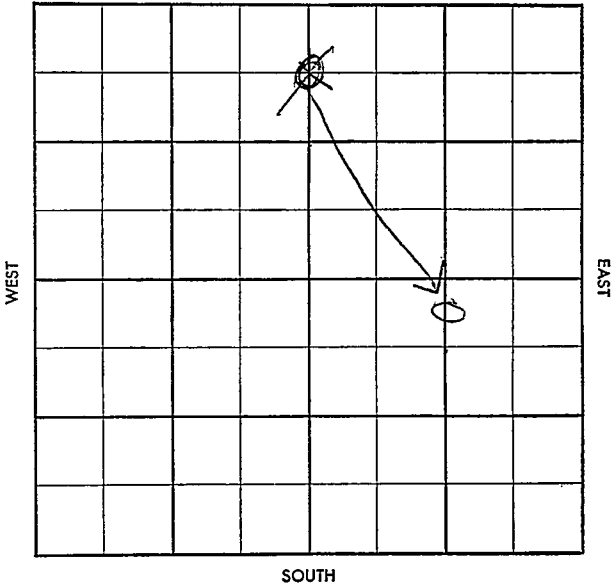

CORRECTION



S-513-A

CO. McPherson ELEV. 15640
SEC. 15 TWP. 19 RGE. 2W
COMPANY Francis O. Hawn NO. 4
etal

ABANDONED
DEC 4 '57

FARM Salthouse

LOC. ~~S N/2 N/2 NE~~ C N/2 N/2 SE

GEOL. _____
CONTR. E.K. Carey tools
POOL Ritz-Canton
SPUD 10-25-57
Location 107 30 5
8" 200
860 NOV 8 '57
3084
KC 2324 Miss
2925 K 3124

MQ 3324 V 2404 S 3442
SSA 3470 Arb 3506
RTD 3780 5 1/2" 3530
NOV 2 '57 DEC 4 '57 CO 3580 TD
inj 200BW 30" arb

SWDW

CO.
SEC.
TWP.
RGE.