


Map No. KANSAS Sec. 15 Twp. 19 R. 2^w
Well No. 1-1 Smith Farm
Carey & Shell Company

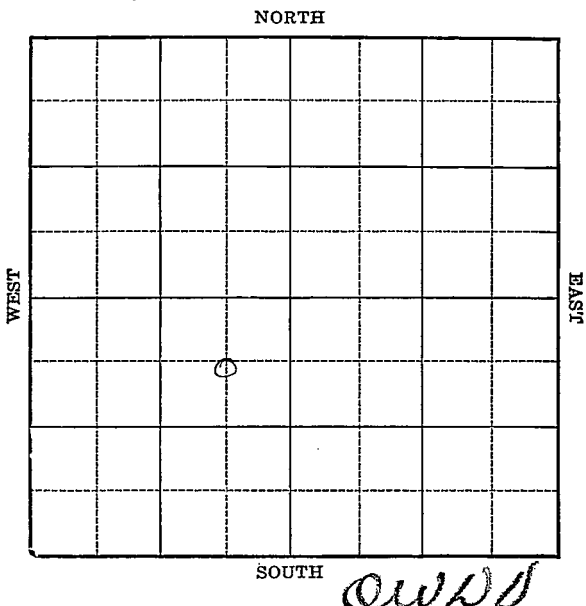

Location _____
Drilling Remarks _____

Rig Up _____
Drilling Remarks _____

RECORD


Cased _____ in. _____ ft.
Sand _____
Gas _____
Oil _____
Total Depth _____

PRODUCTION

1st 24 hrs. Nat. _____
1st 24 hrs. after shot _____
Gas _____ cu. ft.
Dry Hole _____
Abandoned _____

Map No. **KANSAS** Sec. 15 Twp. 19 R. 2^w
 Well No. 1 - Smith Farm
Carey & Shell Company

647 Ft. from N. Line
 _____ Ft. from S. Line
666 Ft. from E. Line
 _____ Ft. from W. Line

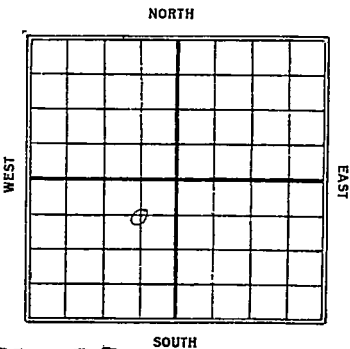

1930

OWN

Date	REPORT
11/19	Loc
11/25	
12/13	Run up
12/10	Stud
12/17	Drlg 1410'
12/23	" 1875
12/30	" 2055
1931	
1/7	drlg 2345
1/14	8" 2476
	drlg 2560
1/21	Top Chat 2928
	Show gas 2930
	UIC 6"
1/28	2 1/2 M gas 2930-35
	Show Oil 2945
	Pay 2968-70
	Mkt 4 1/2 M gas
	and 20 bbl oil an hr.
2/4	No test
2/11	TD. 2972' No test

2/18- T.D. 2972
flow 2 1/2 bbls 24 hr
show water

2/25- Chat 2928-72
T.D. 2972
flow 2 1/2 1/2 bbl
Pay 2968-70
Comp.

OWDD

1934 -

1/24 - Drilling Deeper

1/31 - Rig Up

2/7 — 2/14 — 2/23 —

3/1 —

3/7 abandoned Location

ABANDONED

Map No. KANSAS Sec. 15 Twp. 19 R. 2WWell No. 43 1 SmithCarry & Shell Company

Contractor

SECTION PLAT

647 Ft. from N. Line

Ft. from S. Line

666 Ft. from E. Line

Ft. from W. Line

FIRST REPORTS

Location ✓Rig up ---

Drilling and Remarks:

RECORD

Cased --- in., --- ft.Sand ---Gas ---Oil ---Total Depth ---


PRODUCTION

1st 24 hrs. Nat. ---1st 24 hrs. after shot ---Gas --- Cu. Ft.Dry Hole ---Abandoned ---

Date

NOV 1 9 1920

S. J. LEWIS Scout

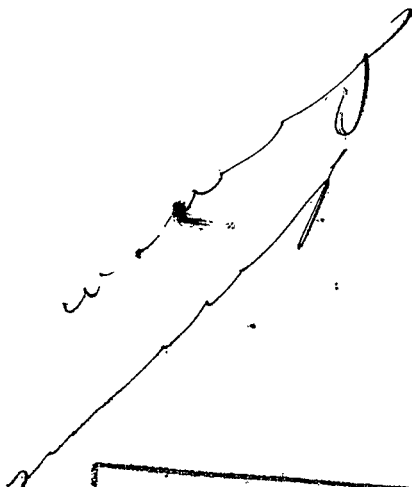

Returned	
Cards	
Tracing	<i>OK</i>
France Map	<i>X</i>
Scarborough Map	<i>[Signature]</i>
Moody Map	<i>[Signature]</i>
Scarborough Flat Book	
Moody Flat Book	

Map No. ANSAS Sec. 15 Twp. 19 R. 2WWell No. 1 SmithCarey & Shell Company

Contractor

SECTION PLAT


647 Ft. from N. Line

Ft. from S. Line

666 Ft. from E. Line

Ft. from W. Line

COMPLETED

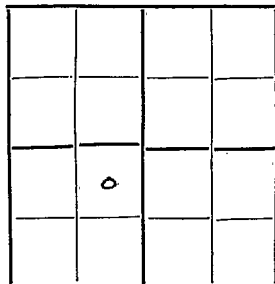

Location

Rig up

Drilling and Remarks:

Flow 212 1/2 gals.Pay 2968-70

RECORD

Cased _____ in., _____ ft.

Sand 2925 - 72

Gas _____

Oil _____

Total Depth 2872

PRODUCTION

1st 24 hrs. Nat. _____

1st 24 hrs. after shot _____

Gas _____ Cu. Ft.

Dry Hole _____

Abandoned _____

Date

FEB 25 1931

S. J. LEWIS Scout

Returned

Cards

Tracing

France Map

Scarborough Map

Moody Map

Scarborough Plat Book

Moody Plat Book

Lib

MUS.

[Signature]

Map No. 43 Sec. 15 Twp. 19 R. 2W

Well No. 1-Smith

Carey et al

Company

~~FIRST REPORTS~~

Contractor

SECTION PLAT

	0		

647 Ft. from N. Line

..... Ft. from S. Line

666 Ft. from E. Line

..... Ft. from W. Line

OWN

Location.....

Rig up.....

Drilling and Remarks:

OTU 2972

Rig up

RECORD

Cased.....in.,ft.

Sand.....

Gas.....

Oil.....

Total Depth.....

PRODUCTION

1st 24 hrs. Nat.....

1st 24 hrs. after shot.....

Gas.....Cu. Ft.

Dry Hole.....

Abandoned.....

Date

1-24-34 192

J. Mannich Scout

survival map

Returned	
Cards	<i>[initials]</i>
Tracing	<i>[initials]</i>
France Map	<i>[initials]</i>
Scarborough Map	<i>[initials]</i>
Moody Map	<i>[initials]</i>
Scarborough Plat Book	
Moody Plat Book	

Form 26-51M/Bks. 9-28
Stephenson

Map No. 43 Sec. 15 Twp. 19 R. 24

Well No. 1-Smith

Carey et al Company

Contractor

ABANDONED

647 Ft. from N. Line

..... Ft. from S. Line

666 Ft. from E. Line

..... Ft. from W. Line

SECTION PLAT

	0		

Location.....

Rig up.....

Drilling and Remarks:

abd cor
Drill bit

RECORD

Cased.....in.,ft.

Sand.....

Gas.....

Oil.....

Total Depth.....

PRODUCTION

1st 24 hrs. Nat.....

1st 24 hrs. after shot.....

Gas.....Cu. Ft.

Dry Hole.....

Abandoned.....

Date

3-7-34

192

Omannschreck Scout

W. J. L.



Returned
Cards
Taping
X
X