


Section 15 Township 19 Range 11W

Well No. #1 Sutton

Company Marmad Oil

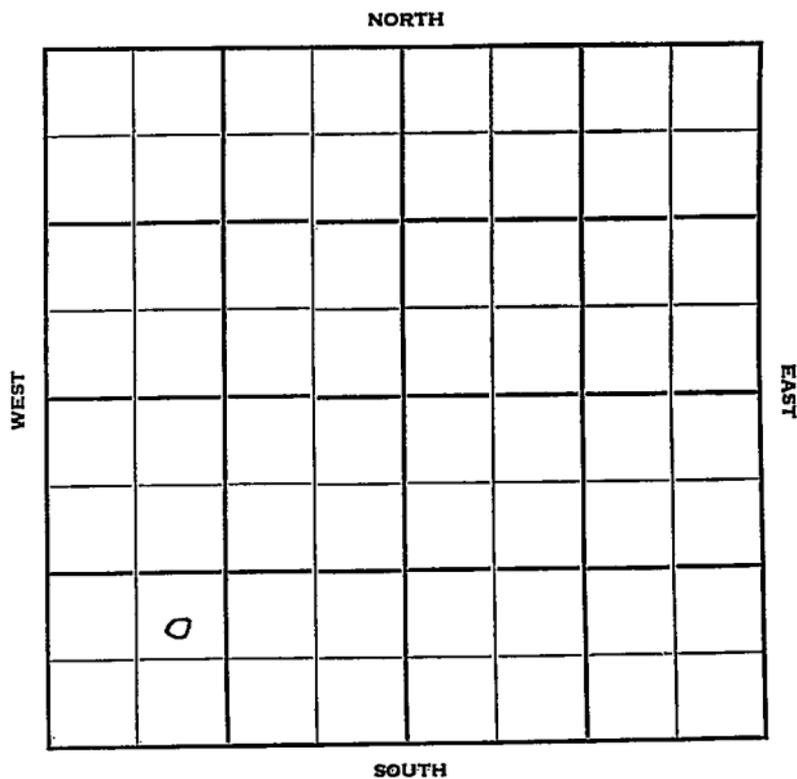

Sec. 15 Twp. 19 R. 11W

Well No. #1 Sutton Farm

Marmad Oil Company

Contractor

Hiezer


Ft. from N. Line

990 Ft. from S. Line

Ft. from E. Line

990 Ft. from W. Line

NE SW SW

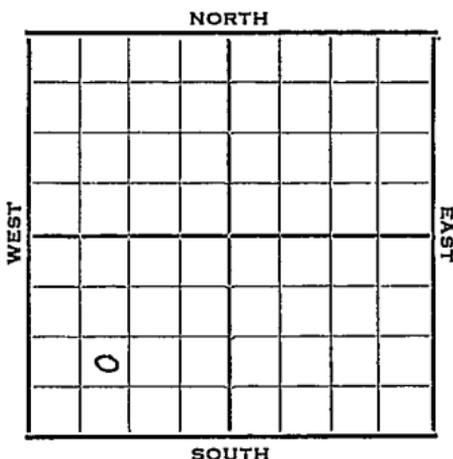

1952 Elev. 1884' REPORT

3/5 Spud 2-28-52
Drlg.

3/11 Heeb. 3112 Br Li 3198
KC 3212
DST 3220-67, 20 mins. 30' GSOCM 0#
DST 3335-55, 1 hr. 270' OCM 90' gas
30' wtr Cong. 3450-85 5" @ 3480' WOC

3/19 B/mud

3/26 Spud 2-28-52
Oil Well TD 3506
8" @ 323
Heeb. 3112 Br Li 3198
KC 3212
DST 3220-67 open 20 min. rec. 30'
VSOCM DST 3335-55 open 1 hr.
rec. 270' ocm 90' gas 30' wtr.
Cong. 3450-85 5" @ 3480 b/ mud
dd 3506 24/ 3240-44 1000 A
S/ 2 boph Comp. 50 bopd

COMPLETED

