FORM 51 25M 8-50 WESTERN Barton KANSAS

Section 15 Township 19 Range 14W

Well No. #1 Webber

Company Isern Bros.

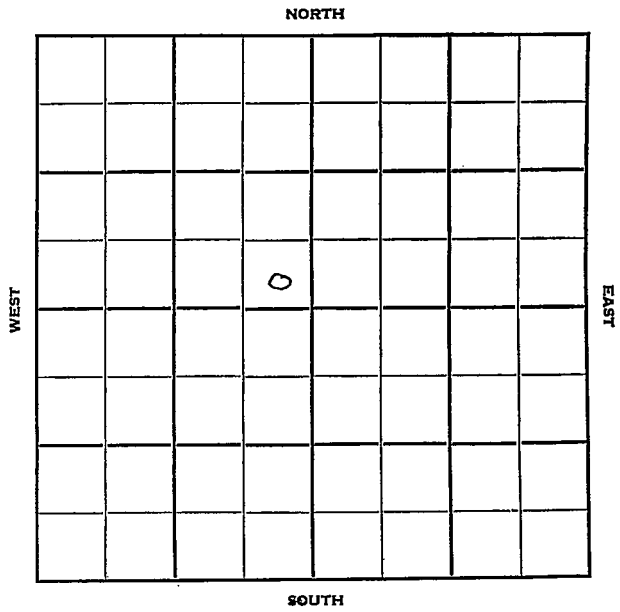

FORM 252-B
10M 10-50 PETROL

Barton

KANSAS

Sec. 15 Twp. 19 R. 14W

Well No. #1 Webber Farm

Isern Bros. Company

Rocks Contractor

Wildcat

____ Ft. from N. Line

330 Ft. from S. Line

330 Ft. from E. Line

____ Ft. from W. Line

SE SE NW

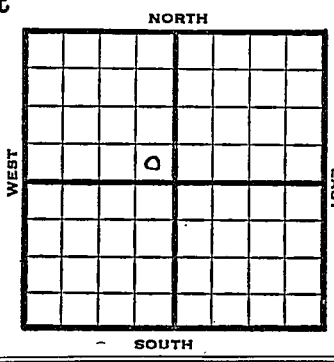

1952 Elev. 1881' REPORT

1/30 Spud 1-26-52
8" @ 845'
Anhy 832' WOC

2/6 Cong. 3487'
TD 3516' 5" @ 3516' CO to 3490'
8/3394-98 1000 A S/14 BOPH
Plug 3385' 8/3353-67' Rng tubing

2/20 1000 A S/ 3½ boph for 8 hrs.POP

3/5 NR

3/11 Est 80 BOPD & 5% wtr.

3/19 NR

3/25 NR

4/1 NR

4/9 Spud 1-26-52
Oil well TD 3516' Anhy 832'
8" @ 845 Lans. 3228'
DST 3230-62 open 1 hr, rec 25' SOCM
DST 3286-3303 open ½ hr, rec 200' oil
DST 3354-66 open ½ hr. rec 1700' oil
Cong. 3487' TD 3516' 5" @ 3516
CO to 3490 8/3394-98 1000 A
S/4 BOPH SP 3385 8/3353-67
1000 A S/3½ BOPH Est 80 BOPD
5% water PB 3485 32/3393-99

OVER

1952
4/9

(Information continued)
1000 A PB 3340' 24/3287-91
S/17 BO 1½ hr.
Comp. 77 BOPD

COMPLETED

FORM 275 FOR SALE BY KANSAS BLUE PRINT CO.

County Barton State Kansas

Sec. 15 (Blk. Twp.) 19 (Sur. Rge.) 14W Map No.

Operator Isern Bros.

Well No. 1 Farm Webber

Elev. Location SE SE NW

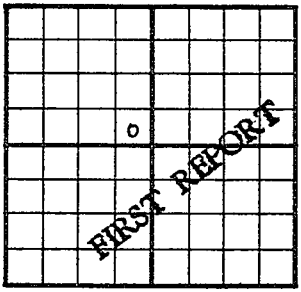

330 Ft. From S Line NW

330 Ft. From E Line Quarter

1st. Report JAN 30 1952

Completion

Remarks

Rocks - Contr.

Spudding Date 1-26-52

Drlg. Data Wildcat

Anhy 832 8" @ 845 WOC

J. G. McGEHEE

FORM 275 FOR SALE BY KANSAS BLUE PRINT CO.

County Barton State Kansas

Sec. 15 (Blk. Twp.) 19 (Sur. Rge.) 14W Map No.

Operator Isern Bros.

Well No. 1 Farm Webber

Elev. 1881 Location SE SE NW

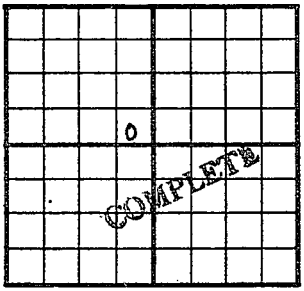

330 Ft. From S Line NW

330 Ft. From E Line Quarter

1st. Report

Completion APR 9 1952

Remarks Wildcat

Rocks - Contr.

Spudding Date 1-26-52

Drlg. Data Oil well TD 3516

Anhy 832 8" @ 845 Lans. 3228

DST 3230-62 open 1 hr. Rec. 25' socm

DST 3286-3303 open ½ hr. Rec. 200' oil

DST 3354-66 open ½ hr. Rec. 1700' oil

Cong. 3487 TD 3516 5" @ 3516 CO to

3490 8/ 3394-98 1000 A S/ 4 boph

SP 3385 8/ 3353-67 1000 A S/ 3½ boph

Est. 80 bopd 5% water PB 3485

32/ 3393-99 1000 A PB 3340

24/ 3287-91 S/ 17 bo 1½ hr.

Comp. 77 bopd

J. G. McGEHEE