

Section 15 Township 19 Range 21 W

Well No. # 1 Bruntz

Company H. Gore et al

13

NORTH

| | | | | | | | |
|---|--|--|--|--|--|--|--|
| | | | | | | | |
| | | | | | | | |
| | | | | | | | |
| | | | | | | | |
| | | | | | | | |
| | | | | | | | |
| | | | | | | | |
| 0 | | | | | | | |

WEST

EAST

SOUTH

Sec. 15 Twp. 19 R. 21 W ✓

Well No. # 1 Bruntz Farm

H. Gore etal Company

Veeder Contractor

Wildcat

_____ Ft. from N. Line


330 Ft. from S. Line

_____ Ft. from E. Line

330 Ft. from W. Line

SW SW SW

Ohio Farmout

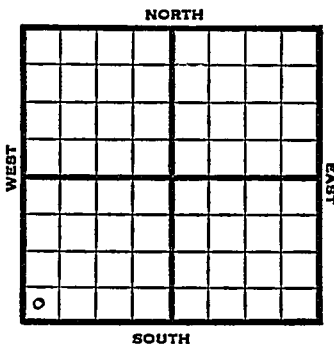

1951

Elev. 2230'

REPORT

(Miss. test)

4/11

M I R

5/9

Spud 4-14-51

D & A TD 4492'

8" @ 306 Top. 3407' Heeb 3739'

Tor. 3767' Lans. 3788' B KC 4061'

Sand 4284-89'

DST 4276-4306 open 1/2 hr. rec 30' OCM

Cong. 4351' Miss 4387'

TD 4492' D & A

ABANDONED

County Ness State Kansas

Sec. 15 (Blk. 19 (Sur. 21W Map No. 19) (Twp. 19 (Rge. 21W))

Operator H. Gore et al.

Well No. 1 Farm Bruntz

Elev. 2230 Location SW SW SW

| | | | | | | | |
|---|--|--|--|--|--|--|--|
| | | | | | | | |
| | | | | | | | |
| 0 | | | | | | | |

330 Ft. From S Line SW

330 Ft. From W Line Quarter

1st. Report

Completion MAY 9 1951

Remarks Wildcat

Veeder - Contr.

Spudding Date 4-14-51

Drlg. Data D & A TD 4492

8" @ 306 Top. 3407 Heeb. 3739

Tor. 3767 Lans. 3788 B KC 4061

Sand 4284-89 DST 4276-4306 open $\frac{1}{2}$ hr.

Rec. 30' ocm Cong. 4351 Miss. 4387

TD 4492 D & A

J. E. TYRA