


Section 15 Township 19 Range 15 WWell No. # 1 UmmenCompany Hilton Drlg.

NORTH

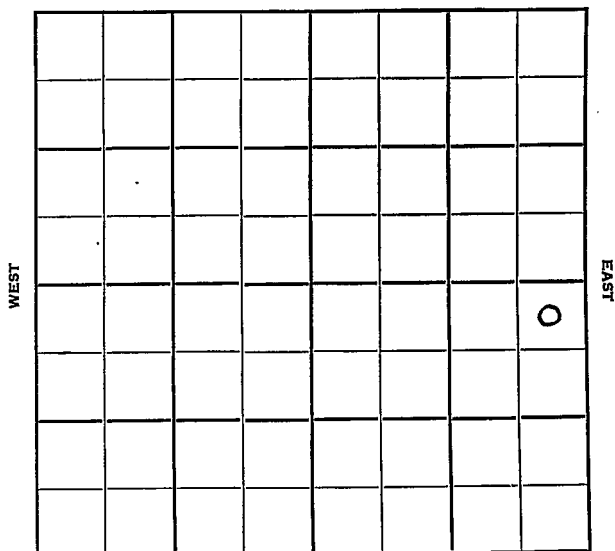

SOUTH

Barton

Sec. 15 Twp. 19 R. 15W ✓

Well No. #1 Ummen Farm

Hilton Drlg. Company


Hilton Drlg. Contractor

330 Ft. from N. Line

 Ft. from S. Line

330 Ft. from E. Line

 Ft. from W. Line

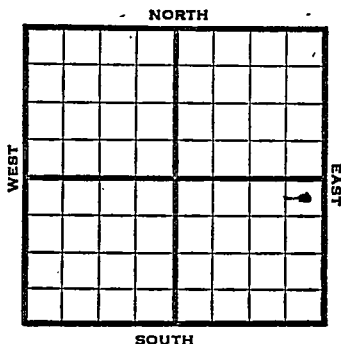

NE NE SE
Phillips acreage
Amerada-DHM

1952

Elev. 1925'

REPORT

2/20 Spud 2-16-52
Anhy 875'
8" @ 890' WOC

3/5 Spud 2-16-52
D. & A TD 3621' Anhy 875'
8" @ 890' Heeb 3164' Br. lime 3242'
Lans. 3252' B KC 3485' Cong. 3504'
Arb. 3582' Regan 3600'
TD 3621' D & A


ABANDONED

County Barton State Kansas
 Sec. 15 (Blk.) 19 (Sur.) 15W Map No.

Operator Hilton Drlg.

Well No. 1 Farm Ummer

Elev. Location NE NE SE

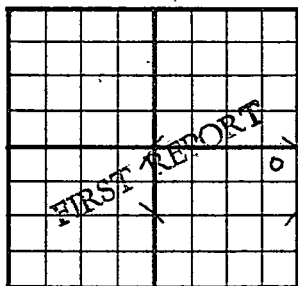

330 Ft. From N Line SE

330 Ft. From E Line Quarter

1st. Report FEB 20 1952

Completion

Remarks Phillips acreage
Amerada Dril

Hilton Drlg. - Contr.


Spudding Date 2-16-52

Drlg. Data

Anhy 375 8" @ 890 WOC

J. G. McGEHEE

County Barton State Kansas
 Sec. 15 (Blk. 19) (Sur. 15W) (Twp.) (Rge.) Map No.
 Operator Hilton Drlg.
 Well No. 1 Farm Ummen
 Elev. 1925 Location NE NE SE

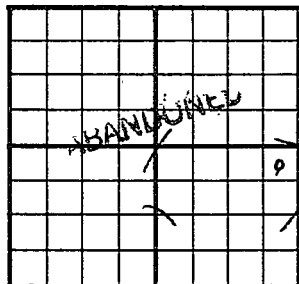

330Ft. From N Line SE

330Ft. From E Line Quarter

1st. Report

Completion **MAR 5 1952**

Remarks

Hilton Drlg. - Contr.Spudding Date 2-16-52Drlg. Data D & A TD 3621Anhy 875 8" @ 890 Heeb. 3164Br. lime 3242 Lans. 3252 B KC 3485Cong. 3504 Arb. 3582 Regan 3600TD 3621 D & A**J. G. McGEHEE**