

Rush


KANSAS

Section 15 Township 19 S Range 20 W

Well No. # 1 Young

Company Republic Nat. & Natural G & O

NORTH

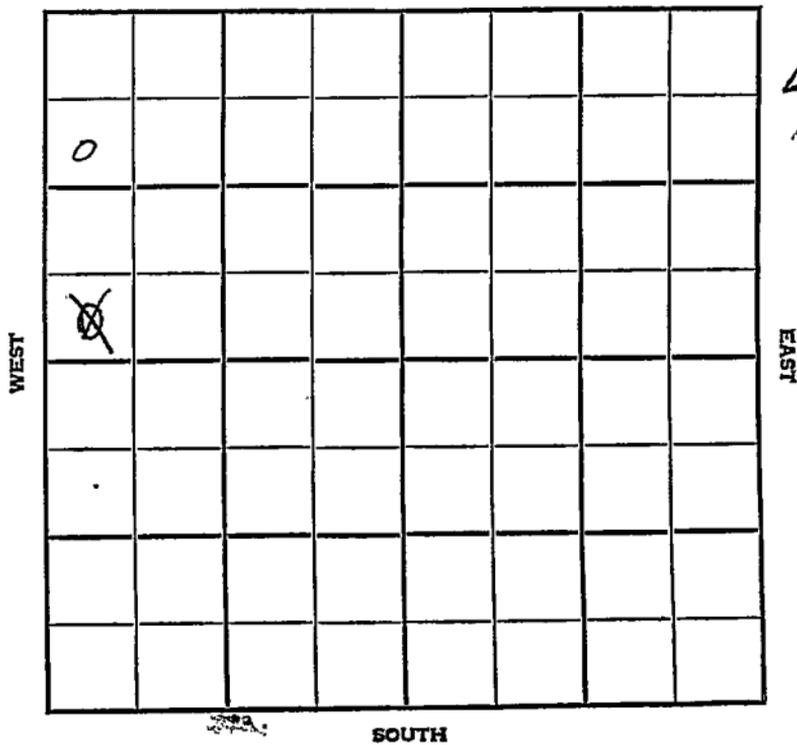

Rush

KANSAS

| | | |
|------|------|------|
| SEC. | TWP. | R. |
| 15 | 19 S | 20 W |

WELL NO. # 1 Young FARM

COMPANY Republic Nat. & Natural G & O

CONTRACTOR Nat. O & G
Unnamed


~~990~~ Ft. from N. Line

~~330~~ Ft. from S. Line

Ft. from E. Line

330 Ft. from W. Line

SW ^{NW} SW NW

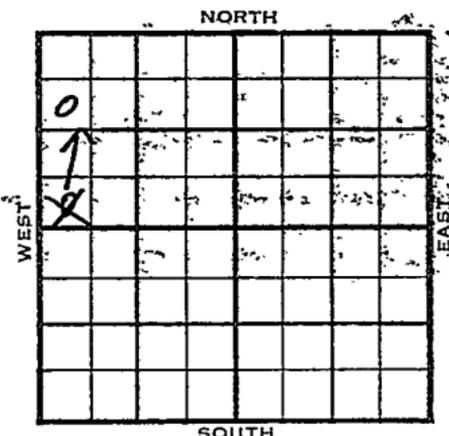

| | | |
|------|-----------|--------|
| 1954 | ELEVATION | REPORT |
| | 2201' | |

12/8 Spud 12-5-54
10" @ 204 w/175 WOC

1955
1/19 Spud 12-5-54 - Oil Well
TD 4488'
10" @ 204'
Any 1410', Cherokee 4198'
DST 4195-4211', opn 1 hr., rec. 3410'
clean oil, 1300#
Miss 4277', Viola 4444',
DST 4430-50', opn 1 hr., rec. 810' SW
1200#
TD 4488'
5" @ 4484'
CO
64/4196-4210
P/9 boph frac
Comp. BHB 3000 bopd

COMPLETED

County Rush State Kansas

Sec. 15 (Blk. Twp.) 19S (Sur. Rge.) 20W Map No.

Operator Republic Nat. & Natural G & O

Well No. 1 Farm Young

Elev. Location SW SW NW

| | | | | | |
|--|--|--|--|--|--|
| | | | | | |
| | | | | | |
330 Ft. From S Line

330 Ft. From W Line NW Quarter

Ist. Report DEC 8 1954

Completion

Remarks Nat. O & G tools

Spudding Date 12-5-54

Drlg. Data Unamed

10" @ 204 w/175, WOC

SCOUT TICKET DX-201

Kansas

| | | |
|------|------|-----|
| SEC. | TWP. | R. |
| 15 | 19S | 20W |

WELL NO.

1 Young

FARM

COMPANY

Republic Natural & Natural O & G

CONTRACTOR

CONNECTION


SW NW NW

990 FT. FROM N. LINE

FT. FROM S. LINE

FT. FORM E. LINE

330 FT. FROM W. LINE

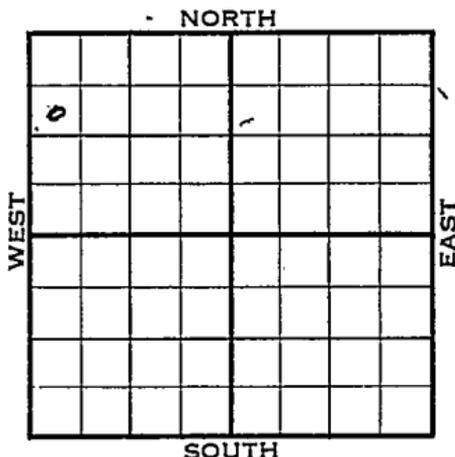

Rush County

LOCATION

RIG UP

DRILLING AND REMARKS:

Reported
SW SW NW

| | |
|------------|------------------------|
| RECORD | CASED IN., FT. |
| | SAND |
| | GAS |
| | OIL |
| PRODUCTION | TOTAL DEPTH |
| | 1ST 24 HRS. NAT. |
| | 1ST 24 HRS. AFTER SHOT |
| | GAS CU. FT. |
| | ABANDONED |

DATE
JAN 5 1955

SCOUT
FABEN GILSTRAP

County Rush State Kansas
 Sec. 15 (Blk. 19 (Sur. 20W Map No. (Twp.) (Rge.))
 Operator Republic Nat. & Natural O & G
 Well No. 1 Farm Young
 Elev. 2201 Location SW NW NW

| | | | | | |
|---|--|--|--|--|--|
| | | | | | |
| 0 | | | | | |
| | | | | | |
| | | | | | |
| | | | | | |
| | | | | | |
| | | | | | |
| | | | | | |

990 Ft. From N Line NW
 330 Ft. From W Line Quarter
 Ist. Report _____
 Completion JAN 19 1955
 Remarks _____
Co. tools
 Spudding Date 12-5-54

Drlg. Data Oil well TD 4488
10" @ 204 Anhy 1410 Cherokee 4198
DST 4195-4211 open 1 hr. Rec. 3410'
clean oil 1300# Miss. 4277 Viola 4444
DST 4430-50 open 1 hr. Rec. 810' sw
1200# TD 4488 5" @ 4484 CO
64/ 4196-4210 P/ 9 boph frac
Comp. BHB 3000 bopd

FABEN GILSTRAP