


Section 16 Township 19 Range 11 W

Well No. # 1 Bieberle "A"

Company C. E. Ash

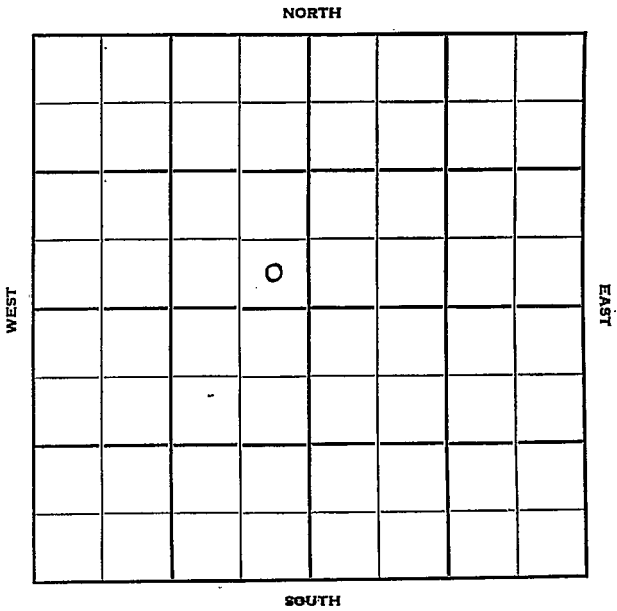

Barton  
19

**KANSAS**

Sec. 16 Twp. \_\_\_\_\_ R. 11W

Well No. #1 Bieberle "A" Farm \_\_\_\_\_

C. E. Ash Company \_\_\_\_\_

Ash - Contr. Contractor \_\_\_\_\_

Wildcat


\_\_\_\_\_ Ft. from N. Line

330' Ft. from S. Line

330' Ft. from E. Line

\_\_\_\_\_ Ft. from W. Line

SE SE NW

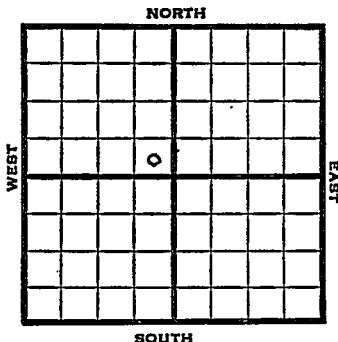

1951

Elev. 1785' REPORT

5/29

RUR

8/22

Spud 5-28-51

D & A TD 3393' 8" @ 242

Anhy 567' Top 2667' Heeb 2949'

Br. lime 3047' Lans. 3065'

DST 3149-61 open 45 min, rec 55' oil & gas cut mud.

DST 3229-43 open 45 min. rec 20' mud

Cong. 3334' Arb. 3342-93'

5" @ 3289 CO to 3258' 40/3232-40

2500 A no inc. PB 3190'

24/3153-59 500 A CO to 3190'

24/3153-59 500 A

D & A

**ABANDONED**


County **Barton** State **Kansas**

Sec. **16** (Blk. Twp.) **19** (Sur. Rge.) **11W** Map No.

Operator **C. E. Ash**

Well No. **1** Farm **Bieberle "A"**

Elev. Location **SE SE NW**

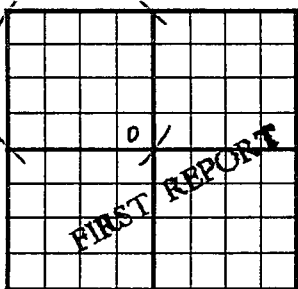

**330** Ft. From **S** Line **NW**

**330** Ft. From **E** Line Quarter

1st. Report **MAY 29 1951**

Completion

Remarks


**Ash - Contr.**

Spudding Date

Drlg. Data **Wildcat**

**R U R**

County Barton State Kansas  
 Sec. 16 (Blk. Twp.) 19 (Sur. Rge.) 11W Map No.  
 Operator C. E. Ash  
 Well No. 1 Farm Bieberle "A"  
 Elev. 1785 Location SE SE NW

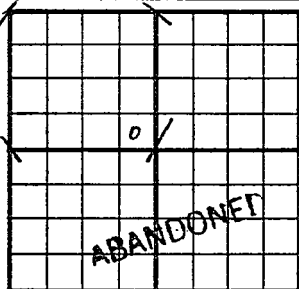

330 Ft. From S Line NW  
330 Ft. From E Line Quarter  
 Ist. Report  
 Completion AUG 22 1951  
 Remarks Wildcat  
Ash - Contr.  
 Spudding Date 5-28-51

Drlg. Data D & A TD 3393  
8" @ 242 Anhy 567 Top. 2667  
Heeb. 2949 Br. lime 3047 Lans. 3065  
DST 3149-61 open 45 min. Rec. 55' oil  
& gcm DST 3229-43 open 45 min.  
Rec. 20' mud Cong. 3334 Arb. 3342-93  
5" @ 3289 CO to 3258 40/ 3232-40  
2500 A no inc. PB 3190 24/ 3153-59  
500 A CO to 3190 24/ 3153-59 500 A

D & A

J. E. TYRA