

KANSAS


FORM 51 5M PETROL

Barton

Section 16 Township 19 Range 11W

Well No. #1 A. Rehme

Company Texas

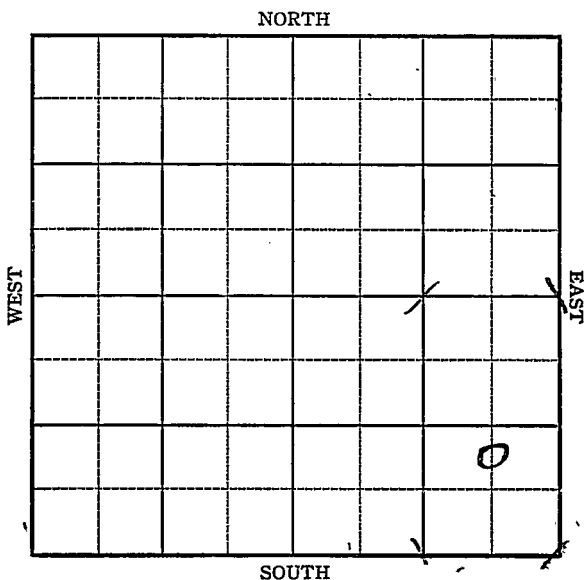

KANSAS

Barton

Sec. 16 Twp. 19 R. 11W

Well No. #1 A. Rehme Farm

Texas Company

Silica


 Ft. from N. Line

990 Ft. from S. Line

660 Ft. from E. Line

 Ft. from W. Line

elev. 1780

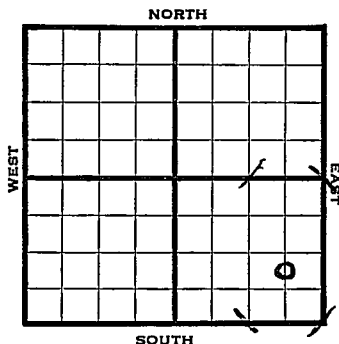

1944

REPORT

3/29 Location

4/5 Rotary

4/12 8" @ 306
Drlg. 2580

4/19 Lans 3062
Cong 3345
Drlg. 3364

4/26 Arb 3444
TD 3460

ABANDONED

KANSAS

Map No. 416 Sec. 16 Twp. 19 R. 11WWell No. 1 A. Rehme

Texas


Company

FIRST REPORT

Contractor

C N L SE SE

SECTION PLAT

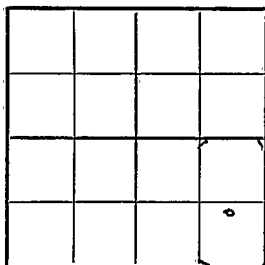

Ft. from N. Line

990

Ft. from S. Line

660

Ft. from E. Line

Ft. from W. Line

Silica Pool

Location X

Rig up

Drilling and Remarks:

RECORD

Cased _____ in., _____ ft.

Sand _____

Gas _____

Oil _____

Total Depth _____

PRODUCTION

1st 24 hrs. Nat. _____

1st 24 hrs. after shot _____

Gas _____ Cu. Ft.

Dry Hole _____

Abandoned _____

Date

MAR 29 1944 19

S. J. LEWIS Scout

Pool Name Silica Pool**KANSAS**Map No. 26 Sec. 16 Twp. 19 R. 11WWell No. 1 A. RehmeTexas

Company _____

ABANDONED

Contractor _____

C N L SE SE

SECTION PLAT

			o

_____ Ft. from N. Line

990 Ft. from S. Line660 Ft. from E. Line

_____ Ft. from W. Line

Barton County

RECORD

Location _____

Cased _____ in., _____ ft.

Rig up _____

Sand _____

Drilling and Remarks:

Gas _____

Oil _____

Total Depth 3760Per 83444

PRODUCTION

1st 24 hrs. Nat. _____

1st 24 hrs. after shot _____

Gas _____ Cu. Ft.

Dry Hole _____

Abandoned _____

Date

APR 26 194419S. J. LEWIS Scout