
FORM 51 25M 3-49 PETROL Barton KANSAS

Section 16 Township 19 Range 11W

Well No. #1 Musenberg "C"

Company C. E. Ash

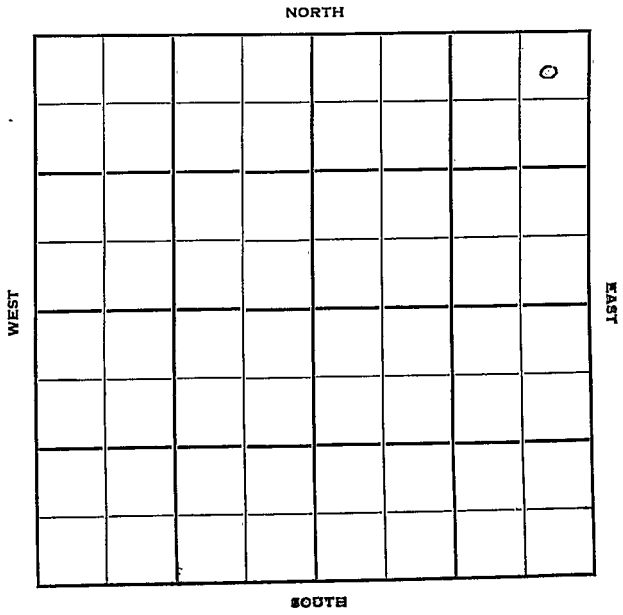

FORM 252-B
10M 11-50 PETROL

KANSAS

Sec. 16 Twp. 19 Barton R. 11W

Well No. #1 Musenberg "C" Farm

C. E. Ash Company

Contractor

Bernard Pool


330' Ft. from N. Line

Ft. from S. Line

330' Ft. from E. Line

Ft. from W. Line

NE NE NE

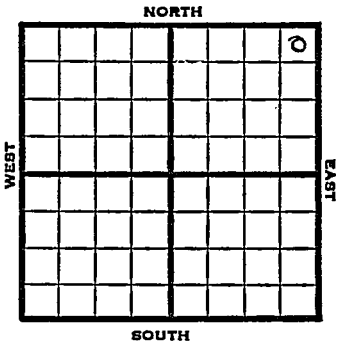

1951	Elev. 1768' REPORT
8/15	Location
8/29	Spud 8-16-51 D & A TD 3385' 8" @ 228 Top 2649' Heeb 2915' Tor. 2933' Br. lime 3035' KC 3054 DST 3184-3201 open 25 min. rec 10' mud Cong 3337' Arb. 3356-85' TD D & A

ABANDONED

FORM 275 FOR SALE BY KANSAS BLUE PRINT CO.


County Barton State Kansas

Sec. 16 (Blk. Twp.) 19 (Sur. Rge.) 11W Map No.

Operator C. E. Ash

Well No. 1 Farm Musenberg "C"

Elev. Location NE NE NE

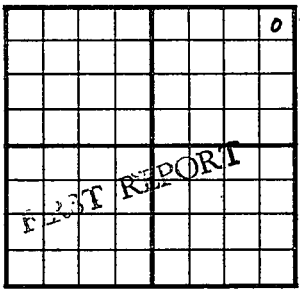

330 Ft. From N Line NE

330 Ft. From E Line Quarter

1st. Report AUG 15 1951

Completion

Remarks

Spudding Date

Drlg. Data Bernard Pool

Location

J. E. TYRA

FORM 275 FOR SALE BY KANSAS BLUE PRINT CO.


County Barton State Kansas

Sec. 16 (Blk. Twp.) 19 (Sur. Rge.) 11W Map No.

Operator C. E. Ash

Well No. 1 Farm Musenberg "C"

Elev. 1768 Location NE NE NE

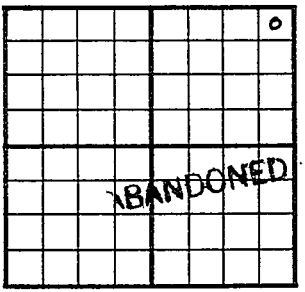

330 Ft. From N Line NE

330 Ft. From E Line Quarter

1st. Report AUG 2 9 1951

Completion

Remarks Bernard Pool

Spudding Date 8-16-51

Drlg. Data D & A TD 3385

8" @ 228 Top. 2649 Heeb. 2915

Tor. 2933 Br. lime 3035 KC 3054

DST 3184-3201 open 25 min. Rec. 10' mud

Cong. 3337 Arb. 3356-85 TD

D & A

J. E. TYRA