

Barton

KANSAS

Section 16 Township 19 Range 12WWell No. #1 SpanierCompany Branine & Hall

NORTH

							0

WEST

EAST

SOUTH

Barton

KANSAS

Sec. 16 Twp. 19 R. 12 W ✓

Well No. # 1 Spanier Farm

Branine & Hall Company

Wildcat Contractor

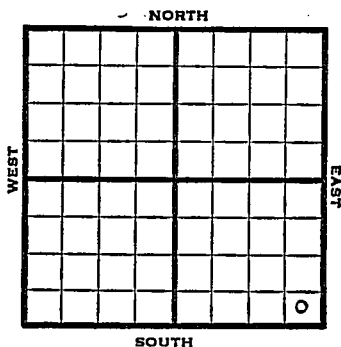
 Ft. from N. Line

330 Ft. from S. Line

330 Ft. from E. Line

 Ft. from W. Line

SE SE SE



1951

Elev. 1867' REPORT

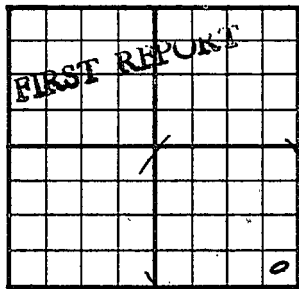
11/7

Spud 11-1-51
8" @ 262
Drlg. 1900'

11/21

Spud 11-1-51
D&A TD 3503
8" @ 262
Heeb. 3048 Br line 3163
Lans. 3180
DST 3204-60 opn 45 min.
Rec. 50' mud Cong. 3440
DST 3441-60 Rec. 10' mud
Arb. 3483 TD 3503
D&A

ABANDONED

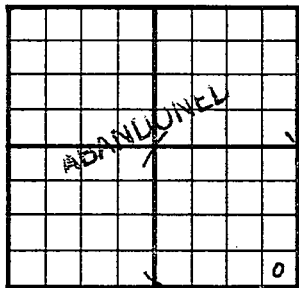
County Barton State KansasSec. 16 (Blk. Twp.) 19 (Sur. Rge.) 12W Map No.Operator Branine & HallWell No. 1 Farm SpanierElev. Location SE SE SE330 Ft. From S Line SE330 Ft. From E Line Quarter1st. Report NOV 7 1951

Completion

Remarks

Spudding Date 11-1-51Drlg. Data Wildcat8" @ 262 Drlg. 1900

J. E. TYRA

County Barton State KansasSec. 16 (Blk. Twp.) 19 (Sur. Rge.) 12W Map No.Operator Branine & HallWell No. 1 Farm SpanierElev. 1867 Location SE SE SE330 Ft. From S Line SE330 Ft. From E Line Quarter

1st. Report

Completion NOV 21 1951Remarks WildcatSpudding Date 11-1-51Drilg. Data D & A TD 35038" @ 262 Heeb. 3048 Br. lime 3163Lans. 3180 DST 3204-60 open 45 min.Rec. 50' mud Cong. 3440 DST 3441-60Rec. 10' mud Arb. 3483 TD 3503D & A

J. E. TYRA