FORM 51 5M 11-44 PETROL


KANSAS Barton county

O.W.W.O.

Section 16 Township 19 Range 12W

Well No. #1, Fish

Company ~~Texas~~ DOZIER OIL

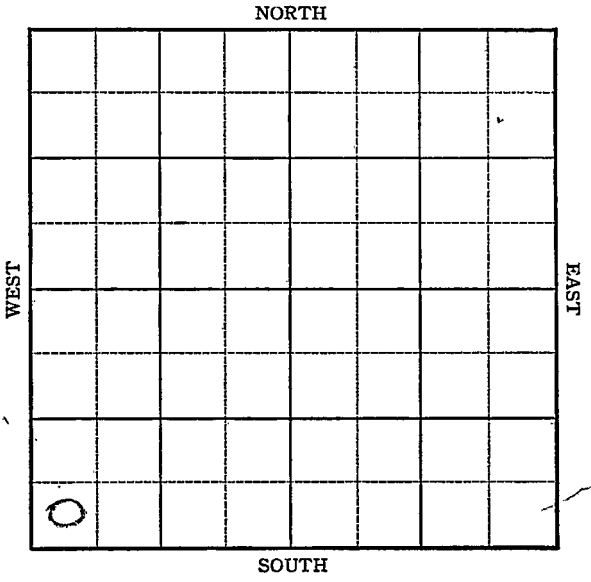

FORM 252-A
5M 12-45 PETROL

KANSAS

Barton County

O.W.W.O.

Sec. 16 Twp. 19 R. 12W

Well No. #1 Fish Farm

Dollar Oil
~~Texas~~ Company

Wildcat


____ Ft. from N. Line

330 Ft. from S. Line

____ Ft. from E. Line

330 Ft. from W. Line

SW/c

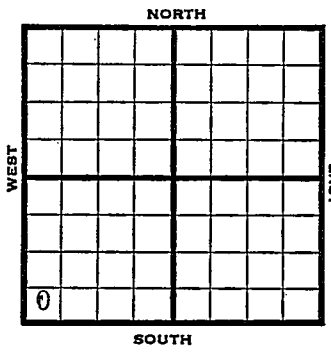

1946	Elev. 1890 REPORT
5/15	RUR
5/21	8" @ 366' Drlg 1735'
5/29	Topeka 2832 Drlg. 3100'
6/5	Lans 3200 Arb. 3496 TD 3565'
	ABANDONED
1952	O.W.W.O.
4/30	Lans. 3200' Cong. 3460' Arb. 3496 OTD 3564' D&A CO 3536' 5" @ 3536'
5/7	D&A TD 3564 Lans. 3200 Cong. 3460 Arb. 3496 OTD 3564 CO to 3536 5" @ 3536 Heeb. 3067 Br Lime 3182 Lans. 3196 Cnng. 3457 48/3458-68 10 goph 19 qt ½ bopn SP 3380 13/3350-56 1000 A 13/3333-37 19/3262-68 1000 A 10 bwph SP 3240 13/3221-25 500 A 100 gwph D&A
	ABANDONED

FORM 26 200 BKS 2-44 PETROL

KANSAS

Kansas Pool Name Wildcat

Map No. 46 Sec. 16 Twp. 19 R. 12W


Well No. 1 Fish

Texas Company

FIRST REPORT Contractor

SW/C

SECTION PLAT

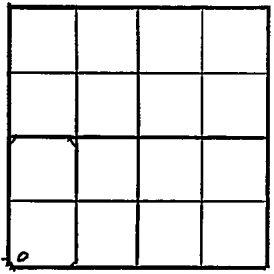

____ Ft. from N. Line

330 Ft. from S. Line

____ Ft. from E. Line

330 Ft. from W. Line

Barton County

Location

Rig up

Drilling and Remarks:

RHR

RECORD

Cased ____ in., ____ ft.

Sand

Gas

Oil

Total Depth

PRODUCTION

1st 24 hrs. Nat.

1st 24 hrs. after shot

Gas ____ Cu. Ft.

Dry Hole

Abandoned

Date

MAY 15 1946 19

S. J. LEWIS Scout

FORM 26 200 BKS. 2-44 PETROL

KANSAS

Kansas Pool Name Wildcat

Map No. 46 Sec. 16 Twp. 19 R. 12W

Well No. 1 Fish


Texas Company

ABANDONED Contractor

SW/C

E 1/2 90

SECTION PLAT

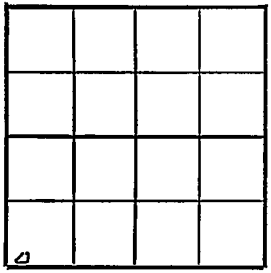

Ft. from N. Line

330 Ft. from S. Line

Ft. from E. Line

330 Ft. from W. Line

Barton County

Location

Rig up

Drilling and Remarks:

Kans 3200

OR 3496

RECORD

Cased in., ft.

Sand

Gas

Oil

Total Depth 3565

PRODUCTION

1st 24 hrs. Nat.

1st 24 hrs. after shot

Gas Cu. Ft.

Dry Hole

Abandoned

Date

JUN 5 1946

19

S. J. LEWIS Scout

FORM 275 FOR SALE BY KANSAS BLUE PRINT CO.

O.W.W.O.


County Barton State Kansas

Sec. 16 (Blk. Twp.) 19 (Sur. Rge.) 12W Map No.

Operator Dozier Oil (was Texas)

Well No. 1 Farm Fish

Elev. 1890 Location SW SW SW

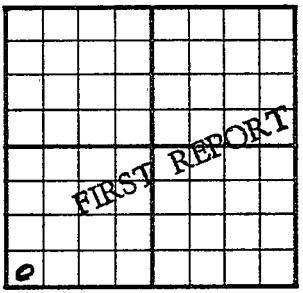

330 Ft. From S Line SW

330 Ft. From W Line Quarter

1st. Report APR 30 1952

Completion

Remarks OWWO

O.W.W.O.

Spudding Date

Drlg. Data

Lans 3200 Conq 3460 Arb 3496 OTD 3564

D&A - CO 3536 5" @ 3536

J. G. McGEHEE

FORM 275 FOR SALE BY KANSAS BLUE PRINT CO.

O.W.W.O.


County Barton State Kansas

Sec. 16 (Blk. Twp.) 19 (Sur. Rge.) 12W Map No.

Operator Dozier Oil (was Texas)

Well No. 1 Farm Fish

Elev. 1890 Location SW SW SW

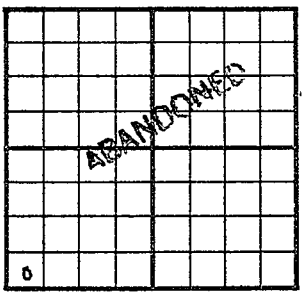

330 Ft. From S Line SW

330 Ft. From W Line Quarter

1st. Report

Completion MAY 7 1952

Remarks OWWO

O.W.W.O.

Spudding Date

Drlg. Data D & A TD 3564

Lans. 3200 Cong. 3460 Arb. 3496

OTD 3564 CO to 3536 5" @ 3536

Heeb. 3067 Br. lime 3182 Lans. 3196

Cong. 3457 48/ 3458-68 10 goph

19 qt/ ½ boph. SP 3380 13/ 3350-56

1000 A 13/ 3333-37 19/ 3262-68

1000 A 10 bwph SP 3240 13/ 3221-25

500 A 100 gwph

D & A

J. G. McGEHEE