

Section 16 Township 19 Range 12-WWell No. #1 KnoppCompany Powell & Peters

NORTH

							2

WEST

EAST

SOUTH

Barton

KANSAS

Sec. 16 Twp. 19 R. 12W

Well No. #1 Knopp Farm

Powell & Peters Company

Powell & Peters Contractor

Wildcat


 Ft. from N. Line

330' Ft. from S. Line

330' Ft. from E. Line

 Ft. from W. Line

SE SE NE

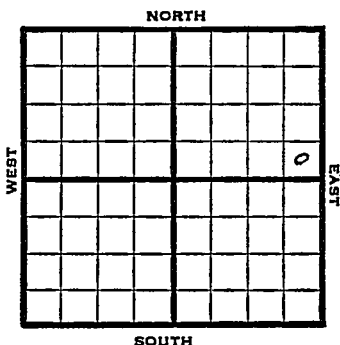

1950

Elev. 1854' REPORT

5/10

Spud 5-3-50
8" @ 232'
Anhy. 690-730

6/7

Drlg. 2142'
8" @ 232'
Heeb 3032'
Lans. 3158'
Cong 3408'
Arb. 3433'
5" @ 3435
TD 3445'
D&A

ABANDONED

Map No. _____ Sec. 16 Twp. 19 R. 12 ^WWell No. 1 KnoppPowell & Peters CompanyPowell & Peters Contractor


SE SE NE

SECTION PLAT

_____ Ft. from N. Line

330 Ft. from S. Line330 Ft. from E. Line

_____ Ft. from W. Line

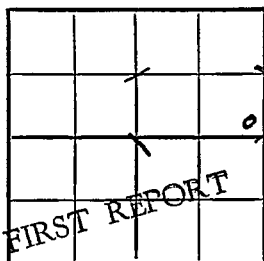Barton

Location _____

Rig up _____

Drilling and Remarks:

Spud 5-3-50

8" @ 232'

Anky 690-730

Drlg. 2142

RECORD

Cased _____ in., _____ ft.

Sand _____

Gas _____

Oil _____

Total Depth _____

PRODUCTION

1st 24 hrs. Nat. _____

1st 24 hrs. after shot _____

Gas _____ Cu. Ft.

Dry Hole _____

Abandoned _____

Date

MAY 10 1950

J. E. TYRA
Scout

Kansas

Map No. _____ Sec. 16 Twp. 19 R. 12W

Well No. 1 Knopp

Powell & Peters Company

Contractor

SE SE NE


E1.1854
SECTION PLAT

_____ Ft. from N. Line

330 Ft. from S. Line

330 Ft. from E. Line

_____ Ft. from W. Line

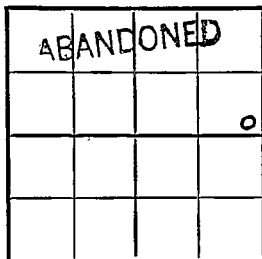

Barton

Location _____

Rig up _____

Drilling and Remarks:

8" @ 232
 Kub 3032
 Lens 3158
 Cong 3408
 arb 3433
 5" @ 3435

RECORD

Cased _____ in., _____ ft.

Sand _____

Gas _____

Oil _____

Total Depth 3445

PRODUCTION

1st 24 hrs. Nat. _____

1st 24 hrs. after shot _____

Gas _____ Cu. Ft.

Dry Hole _____

Abandoned _____

Date

D & A

JUN 7 1950 19

J. E. TYRA Scout