


Section 16 Township 19 Range 12-W

Well No. #1-Rascoe

Company Herbert Dustin

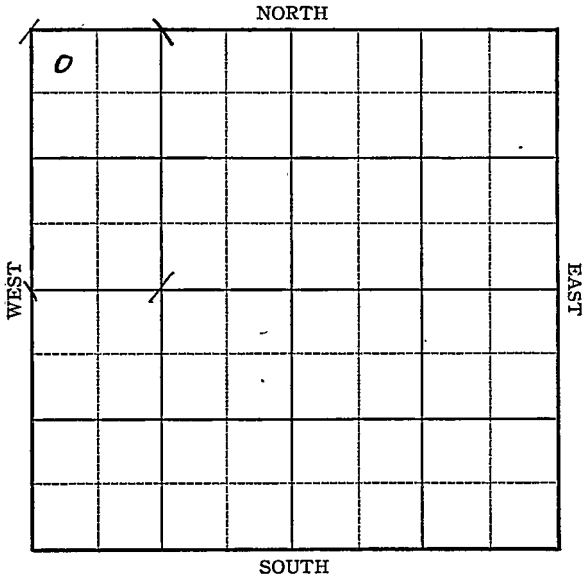

Sec. 16 Twp. 19 R. 12-W

Well No. #1 Rascoe Farm

Herbert Dustin Company

Wildcat


330 Ft. from N. Line

\_\_\_\_\_ Ft. from S. Line

\_\_\_\_\_ Ft. from E. Line

330 Ft. from W. Line

*Elev. 1854*

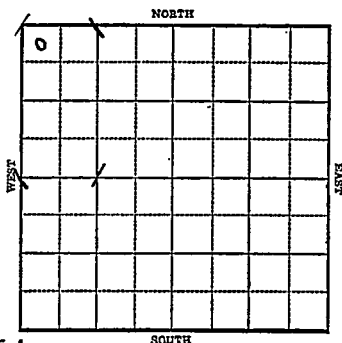

1943

R E P O R T

- 6/23 Cellar
- 6/30 "
- 7/7 Surface hole
- 7/15 8" @ 218  
Anhy 695  
Topeka 2770  
Drlg. 2947
- 7/21 Arb. 3439  
T.D. 3481'

**ABANDONED**

**KANSAS**

**Barton**

Map No. 46 Sec. 16 Twp. 19 R. 12W

Well No. 1 Rascoe

Herbert Dustin Company

FIRST REPORT Contractor

**NW/C**

**SECTION PLAT**

330 Ft. from N. Line


\_\_\_\_\_ Ft. from S. Line

\_\_\_\_\_ Ft. from E. Line

330 Ft. from W. Line

**WILDCAT**

**RECORD**

Location \_\_\_\_\_

Cased \_\_\_\_\_ in., \_\_\_\_\_ ft.

Rig up \_\_\_\_\_

Sand \_\_\_\_\_

Drilling and Remarks:

Gas \_\_\_\_\_

Oil \_\_\_\_\_

Total Depth \_\_\_\_\_

**Cellar**

**PRODUCTION**

1st 24 hrs. Nat. \_\_\_\_\_

1st 24 hrs. after shot \_\_\_\_\_

Gas \_\_\_\_\_ Cu. Ft.

Dry Hole \_\_\_\_\_

Abandoned \_\_\_\_\_

Date

JUN 23 1943 19

S. I. LEWIS Scout

**KANSAS**  
 Map No. 76 Sec. 16 Twp. 19 R. 12W

Well No. 1 Rascoe

Herbert Dustin

Company

ABANDONED

Contractor

## SECTION PLAT

330 NW/C  
 Ft. from N. Line

Ft. from S. Line

Ft. from E. Line

330 Ft. from W. Line

0			

WILDCA'

Location \_\_\_\_\_

Rig up \_\_\_\_\_

Drilling and Remarks:

*Per 3439*

## RECORD

Cased \_\_\_\_\_ in., \_\_\_\_\_ ft.

Sand \_\_\_\_\_

Gas \_\_\_\_\_

Oil \_\_\_\_\_

Total Depth 3481

## PRODUCTION

1st 24 hrs. Nat. \_\_\_\_\_

1st 24 hrs. after shot \_\_\_\_\_

Gas \_\_\_\_\_ Cu. Ft.

Dry Hole \_\_\_\_\_

Abandoned \_\_\_\_\_

Date

JUL 21 1943 19

S. J. LEWIS Scout