


Section 16 Township 19 Range 10W

Well No. #1 Herzog "A"

Company C. E. Ash

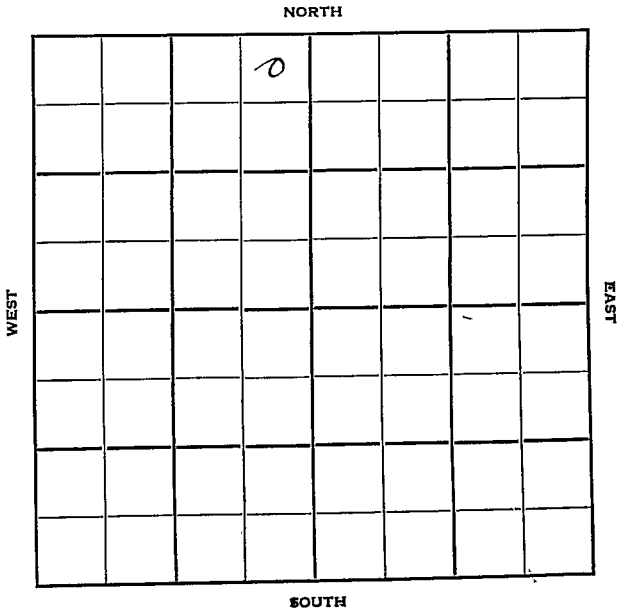

KANSAS

Rice

19

LOW

Sec. 16 Twp. R.

Well No. #1 Herzog "A" Farm

C. E. Ash Company

Contractor


330' Ft. from N. Line

Ft. from S. Line

330' Ft. from E. Line

Ft. from W. Line

NE NE NW

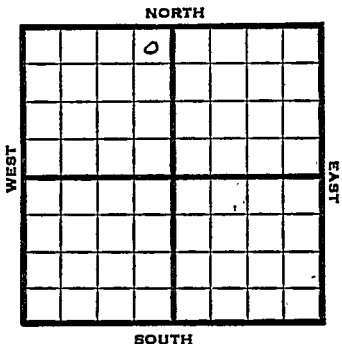

1950

Elev 1772' REPORT

3/29

Location

4/12

TD 3390'

8" @ 233'

Topeka 2599'

Heeb 2868'

Br L 2990'

Lans 3013'

Cong 3298'

Arb. 3352'

Arb. 3352'

No shows.

D&A

Aband.


ABANDONED

Kansas

Map No. _____ Sec. 16 Twp. 19 R. 10WWell No. 1 Herzog "A"_____C. E. Ash_____
Company_____
Contractor

NE NE NW

SECTION PLAT

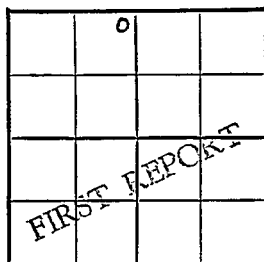330 Ft. from N. Line_____
Ft. from S. Line330 Ft. from E. Line_____
Ft. from W. Line

Rice County

Location X

Rig up _____

Drilling and Remarks:

RECORD

Cased _____ in., _____ ft.

Sand _____

Gas _____

Oil _____

Total Depth _____

PRODUCTION

1st 24 hrs. Nat. _____

1st 24 hrs. after shot _____

Gas _____ Cu. Ft.

Dry Hole _____

Abandoned _____

Date

MAR 29 1930J. E. TYRA Scout

Kansas

Map No. _____ Sec. 16 Twp. 19 R. 10WWell No. 1 Herzog "A"C. E. Ash Company

Contractor


NE NE NW

E. 1772
SECTION PLAT330 Ft. from N. Line

_____ Ft. from S. Line

330 Ft. from E. Line

_____ Ft. from W. Line

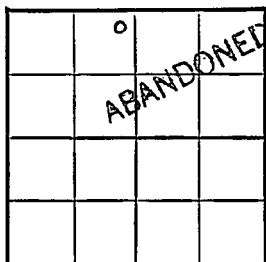

Rice County

Location _____

Rig up _____

Drilling and Remarks:

8" @ 233
 Topok 2599
 Reel 2868
 Brd 2990
 Lenz 3013
 Cong 3298
 Dub 3352

RECORD

Cased _____ in., _____ ft.

Sand _____

Gas _____

Oil _____

Total Depth 3390

PRODUCTION

1st 24 hrs. Nat. _____

1st 24 hrs. after shot _____

Gas _____ Cu. Ft.

Dry Hole _____

Abandoned _____

Date

APR 12 1950

19

J. E. TYRA

Scout