

KANSAS


Rice

FORM 51 5M 4-41 PETROL

Section 16 Township 19 Range 10-W

Well No: 1 Jochems

Company I. W. Murfin et al

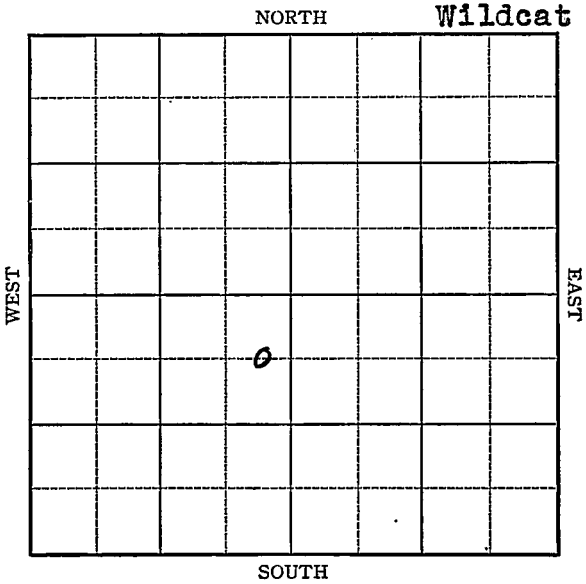

Sec. 16 Twp. 19 R. 10-W

Well No. #1 Jochems Farm

I. W. Murfin et al Company
(Wildcat)


660 Ft. from N. Line

_____ Ft. from S. Line

330 Ft. from E. Line

_____ Ft. from W. Line

Elev. 1766

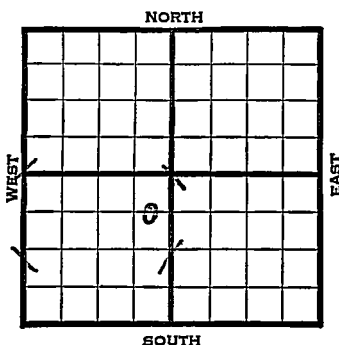

1941	REPORT
5/7	Cable.
5/15	"
5/22	"
5/28	"
6/5	"
6/12	15" - 193' Anhy 480'
	12" - 485' Drlg. 570'
6/19	Drlg. 1605'
6/26	10" - 1766' Drlg. 2095'
7/3	Topeka 2600' Drlg. 2650'
7/10	Lans. 3010' 7" - 2985'
	T.D. 3138' U.R. 7".
7/17	7" - 3121' Arb. 3330'
	131' of 5" liner at 3312'
	Drlg. 3354' S.S.O.
	OVER

1941

7/23

Arb. 3321'

T.D. 3369'

H.F.W.

ABANDONED

Map No. 46 Sec. 16 Twp. 19 R. 10WWell No. 1 Jochems

I. W. Murfin etal

Company

FIRST REPORT

Contractor

SECTION PLAT


C E L N E S W

660 Ft. from N. Line

_____ Ft. from S. Line

330 Ft. from E. Line

_____ Ft. from W. Line

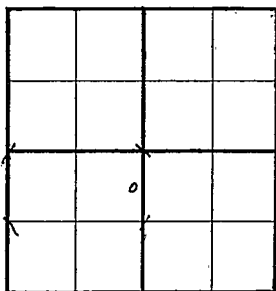

WILDCAT

Location _____

Rig up _____

Drilling and Remarks:

CABLE

RECORD

Cased _____ in., _____ ft.

Sand _____

Gas _____

Oil _____

Total Depth _____

PRODUCTION

1st 24 hrs. Nat. _____

1st 24 hrs. after shot _____

Gas _____ Cu. Ft.

Dry Hole _____

Abandoned _____

Date

MAY 7 1941 19

S. J. LEWIS

Scout

Misc. Small Maps
Cards
Tracing
France Map
Scarborough Map
Woody Map
Geological Dept.
Moody Plat Book

Map No. _____ Sec. 16 Twp. 19 R. 10WWell No. 1 JochemsI. W. Murfin etal

Company

ABANDONED

Contractor

SECTION PLAT

C E L N E S W

660 Ft. from N. Line

_____ Ft. from S. Line

330 Ft. from E. Line

_____ Ft. from W. Line

WILDCA T

		0	

Location _____

Rig up _____

Drilling and Remarks:

Per X 2321H.F.W.

RECORD

Cased _____ in., _____ ft.

Sand _____

Gas _____

Oil _____

Total Depth 3369

PRODUCTION

1st 24 hrs. Nat. _____

1st 24 hrs. after shot _____

Gas _____ Cu. Ft.

Dry Hole _____

Abandoned _____

Date

JUL 23 1941 19S. J. LEWIS Scout

Misc Small Maps	
Cards	
Tracing	
France Map	
Scarborough Map	
Moody Map	
Geological Dept.	
Moody Plat Book	

