


Section 16 Township 19 Range 10-W

Well No. #1 Bernstroff

Company Bishop Oil

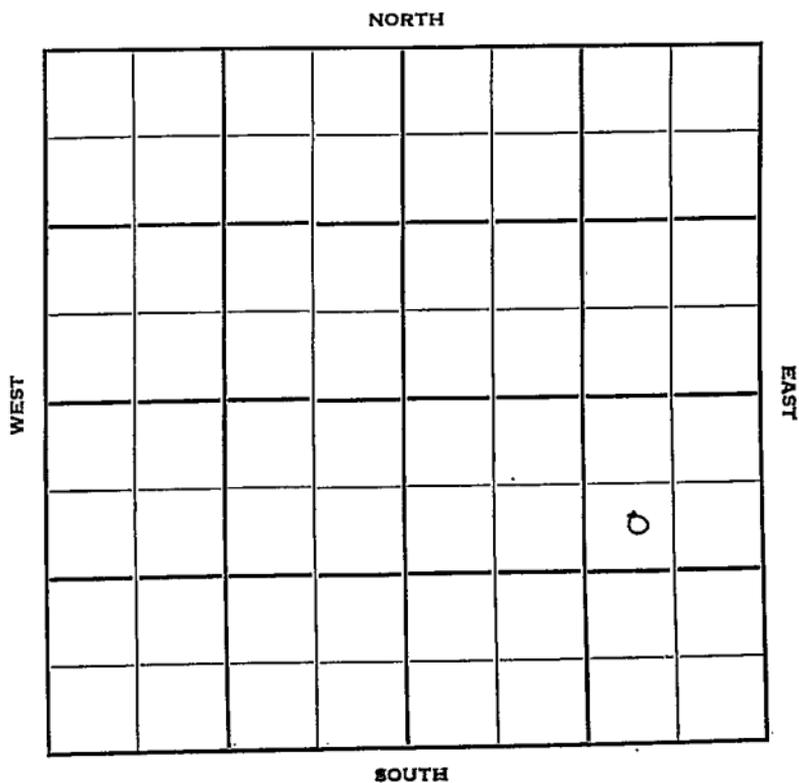

Rice

KANSAS

Sec. 16 Twp. 19 R. 10W

Well No. #1 Bernstroff Farm

Bishop Oil Company

Bishop Contr. Contractor

Silica


990' Ft. from N. Line

_____ Ft. from S. Line

990' Ft. from E. Line

_____ Ft. from W. Line

SW NE SE

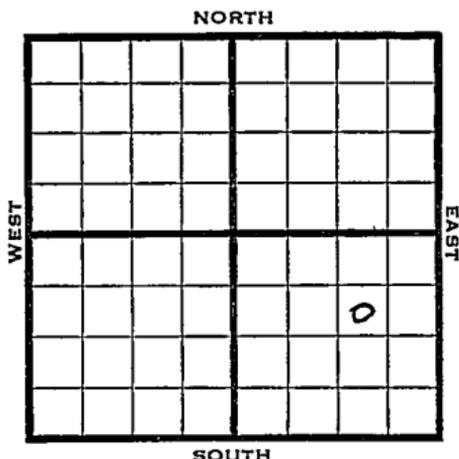

1950 Elev. 1771' REPORT

8/9 Set surface

10/18 Spud 8-15-50
Oil Well TD 3320'
8-5/8" @ 256'
Br Lime 2950' Lans. 2975'
DST 3058-68 opn 19 min
Red. 240' O& GCM
Cong. 3280-3320 TD
4" @ 3140
12/3062-65
500 A S/75 BOPD 2500 A
Comp. 41 BOPD
COMPLETED

County Rice State Kansas

Sec. 16 (Blk. 19) (Sur. Rge.) 10W Map No.

Operator Bishop Oil

Well No. 1 Farm Bernstreff

Elev. _____ Location SW NE SE

FIRST REPORT

990 Ft. From N Line SE

990 Ft. From R Line Quarter

1st. Report AUG 9 1950

Completion _____

Remarks _____

Spudding Date _____

Drig. Data Silica Pool

Set surface

J. E. TYRA

County Rice State Kansas

Sec. 16 (Blk. 19) (Sur. 10W) (Twp.) (Rge.) Map No.

Operator Bishop Oil

Well No. 1 Farm Bernstroff

Elev. 1771 Location SW NE SE

COMPLETE

990 Ft. From N Line SE

990 Ft. From E Line Quarter

1st. Report

Completion OCT 18 1950

Remarks Silica Pool

Bishop - Contr.

Spudding Date 8-15-50

Drlg. Data Oil well TD 3320

8 5/8" @ 256 Br. limè 2950 Lans. 2975

DST 3058-68 open 19 min. Rec. 240' o & gm

Cong. 3280-3320 TD 4" @ 3140 12/ 3062-65

500 A S/ 75 bopd 2500 A Comp. 41 bopd