

Section 16 Township 19 Range 10WWell No. #1 HammellCompany Sterling Drlg.

NORTH

|  |  |  |  |  |  |  |   |
|--|--|--|--|--|--|--|---|
|  |  |  |  |  |  |  |   |
|  |  |  |  |  |  |  |   |
|  |  |  |  |  |  |  |   |
|  |  |  |  |  |  |  | 9 |
|  |  |  |  |  |  |  |   |
|  |  |  |  |  |  |  |   |
|  |  |  |  |  |  |  |   |
|  |  |  |  |  |  |  |   |

WEST

EAST

SOUTH

Rice

KANSAS

Sec. 16 Twp. 19 R. 10W ✓

Well No. #1 Hammell Farm

Sterling Drlg. Company

Chase Contractor

Ft. from N. Line

330

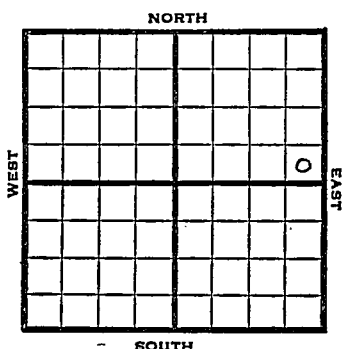
Ft. from S. Line

330

Ft. from E. Line

Ft. from W. Line

SE SE NE



1952

Elev. 1757'

REPORT

1/30

Spud 1-24-52

8" @ 206'

Drlg. 2035'

2/6

Spud 1-24-52

D&A TD 3335'

8" @ 206

Heeb. 2816

Br. Li 2938

Lans. 2957

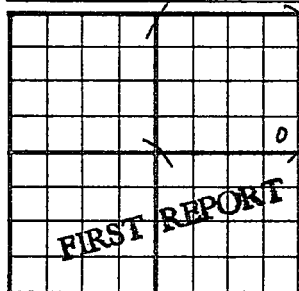
Cong. 3283

Arb. 3311

TD 3335

D&A

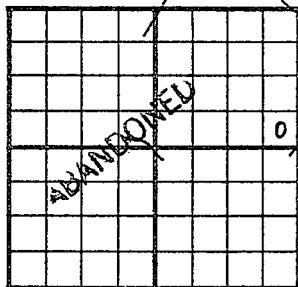
**ABANDONED**

County Rice State KansasSec. 16 (Blk.) 19 (Sur.) 10W Map No.Operator Sterling Drlg.Well No. 1 Farm HammellElev. Location SE SE NE330 Ft. From S Line NE330 Ft. From E Line Quarter1st. Report JAN 30 1952

Completion

Remarks

Sterling - Contr.Spudding Date 1-24-52Drlg. Data Chase8" @ 206 · Drlg. 2035J. G. MCGHEE

County Rice State KansasSec. 16 (<sup>Blk.</sup><sub>Twp.</sub>) 19 (<sup>Sur.</sup><sub>Rge.</sub>) 10W Map No.Operator Sterling Drlg.Well No. 1 Farm HammellElev. 1757 Location SE SE NE330 Ft. From S Line NE330 Ft. From E Line Quarter

1st. Report

Completion FEB 6 1952Remarks Chase PoolSterling Drlg. - Contr.Spudding Date 1-24-52Drlg. Data D & A TD 33358" @ 206 Heeb. 2816 Br. lime 2938Lans. 2957 Cong. 3283 Arb. 3311TD 3335 D & A

J. G. McGEHEE