


Section 16 Township 19 Range 10W

Well No. 1 Hammel

Company Florney & Williams

Wildcat

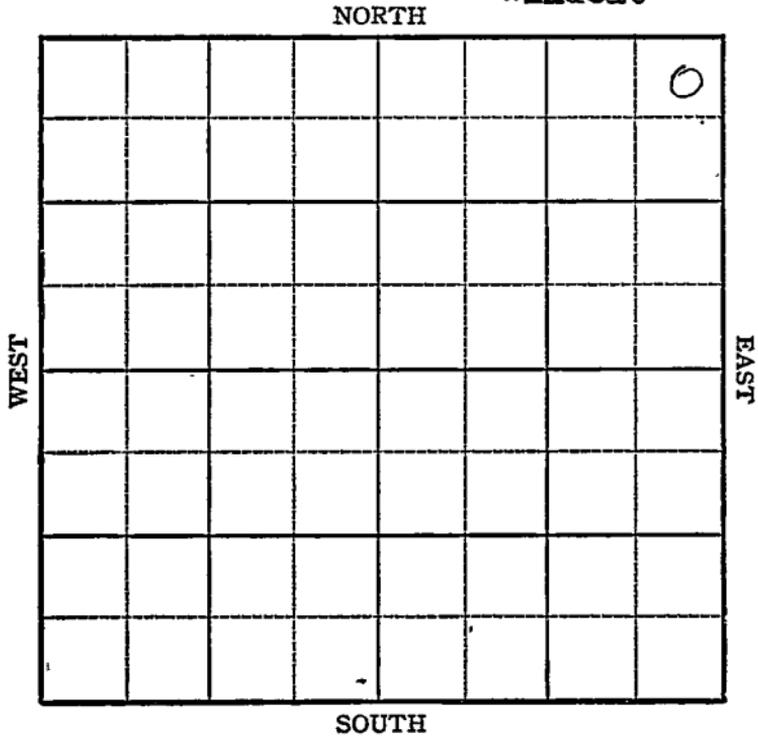

KANSAS

Rice



Sec. 16 Twp. 19 R. 10W

Well No. #1 Hammel Farm

Florney & Williams Company

Wildcat


330' Ft. from N. Line

\_\_\_\_\_ Ft. from S. Line

330' Ft. from E. Line

\_\_\_\_\_ Ft. from W. Line

NE/C

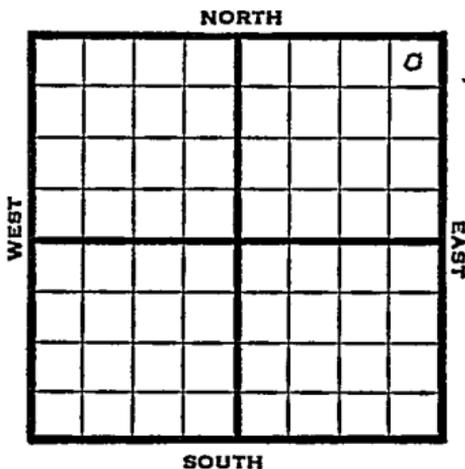

1948

Eli 1760' REPORT

9/8

8" @ 198'  
Drlg. 2761'

9/15

Lansing 3090'  
TD 3095'  
Aband.  
**ABANDONED**

Rice County Kansas State  
 Map No. \_\_\_\_\_ Sec. 16 Twp. 19 R. 10W

Well No. 1 Hammel

Florney & Williams Company

**FIRST REPORT**

\_\_\_\_\_  
 Contractor

NE/C

**SECTION PLAT**

330 Ft. from N. Line

\_\_\_\_\_ Ft. from S. Line

330 Ft. from E. Line

\_\_\_\_\_ Ft. from W. Line

									o

Wildcat  
 Remarks:

8" @ 198 drlg. 2761

Date  
 SEP 8 1948

Scout  
 S. J. LEWIS

Rice County Kansas State

Map No. 46 Sec. 16 Twp. 19 R. 10W

Well No. 1 Hammel

Florney & Williams Company

**ABANDONED**

Contractor

NE/C

E1,1760

**SECTION PLAT**

330 Ft. from N. Line

\_\_\_\_\_ Ft. from S. Line

330 Ft. from E. Line

\_\_\_\_\_ Ft. from W. Line

									0

Wildcat

Remarks:

*Lane 2090*

*Y113895*

*SEP 15 1948*

*1 20 5*

*20*

Date  
SEP 15 1948

Scout **S. J. LEWIS**