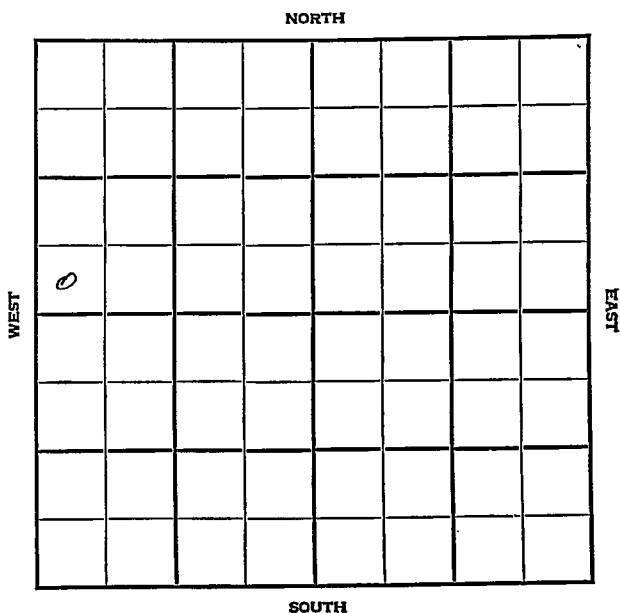


KANSAS

Section 16 Township 19 Range 10^WWell No. #1 Wendel "A"Company C.E. Ash

Sec. 16 Twp. 19 R. 10W

Well No. #1 Wendel "A" Farm

C. E. Ash Company

Wildcat


 Ft. from N. Line

330 Ft. from S. Line

 Ft. from E. Line

330 Ft. from W. Line

SW NW

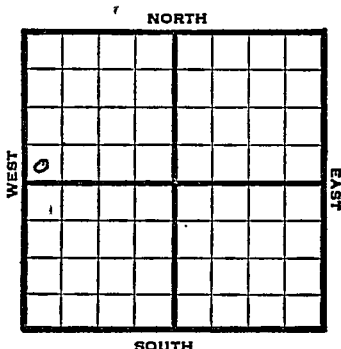

1947

Elev. 1723 REPORT

11/19 Location

11/25 8" @ 184'
WOC

12/3 Drlg. 2750'

12/10 Lansing 3014'
Arbuckle 3325'
TD 3333'
5" @ 3328'
RUST

12/17 "

12/30 "

1948
1/7 TD 3337' - 1000 acid
300' oil 18 hrs.
Drlg. 3340'

1/14 Arb. 3325'
5" @ 3328'
1000 acid
Pump 25 Pot
43.6 Gr.
TD 3357'
Comp.


COMPLETED

Kansas

Map No. _____ Sec. 16 Twp. 19 R. 10WWell No. 1 Wendel "A"C. E. Ash CompanyFIRST REPORT Contractor

SW NW

SECTION PLAT

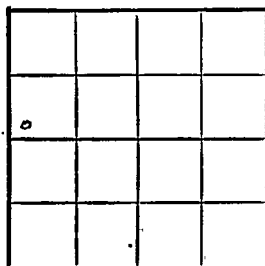

_____ Ft. from N. Line

330 Ft. from S. Line

_____ Ft. from E. Line

330 Ft. from W. LineRice CountyLocation X

Rig up _____

Drilling and Remarks:

RECORD

Cased _____ in., _____ ft.

Sand _____

Gas _____

Oil _____

Total Depth _____

PRODUCTION

1st 24 hrs. Nat. _____

1st 24 hrs. after shot _____

Gas _____ Cu. Ft.

Dry Hole _____

Abandoned _____

Date

NOV 19 1947S. J. LEWIS Scout

Map No. 46 Sec. 16 Twp. 19 R. 10W

Well No. 1 Wendel "A"

C. E. Ash Company

COMPLETE

Contractor

SW NW

E 11723


SECTION PLAT

 Ft. from N. Line

330 Ft. from S. Line

 Ft. from E. Line

330 Ft. from W. Line

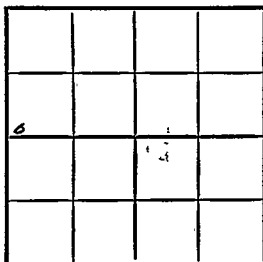

Rice County

Location

Rig up

Drilling and Remarks:

Cur 3325

5" 63325

10000000

Aug 25 1948

42 6/8

RECORD

Cased in., ft.

Sand

Gas

Oil ✓

Total Depth 3325

PRODUCTION

1st 24 hrs. Nat.

1st 24 hrs. after shot

Gas Cu. Ft.

Dry Hole

Abandoned

Date

JAN 14 1948

19

S. J. LEWIS

Scout